


100 POWER IN 460-3-60
101
102
SHORT CIRCUIT CURRENT 5 kA rms SYMMETRICAL, 460 V MAXIMUM


WIRE SPECIFICATIONS

WIRE TYPE: MTW/TEW
POWER WIRE: BLACK - 12 AWG
CONTROL WIRE: RED - 16 AWG
NEUTRAL WIRE: WHITE - 16 AWG
DC WIRE: BLUE - 16 AWG
GROUND WIRE: GREEN - 12 AWG
GFCI GROUND WIRE: GREEN - 12 AWG (SOLID)
SHIELDED CABLE: BELDEN - 18 AWG

*** UNLESS OTHERWISE NOTED ***

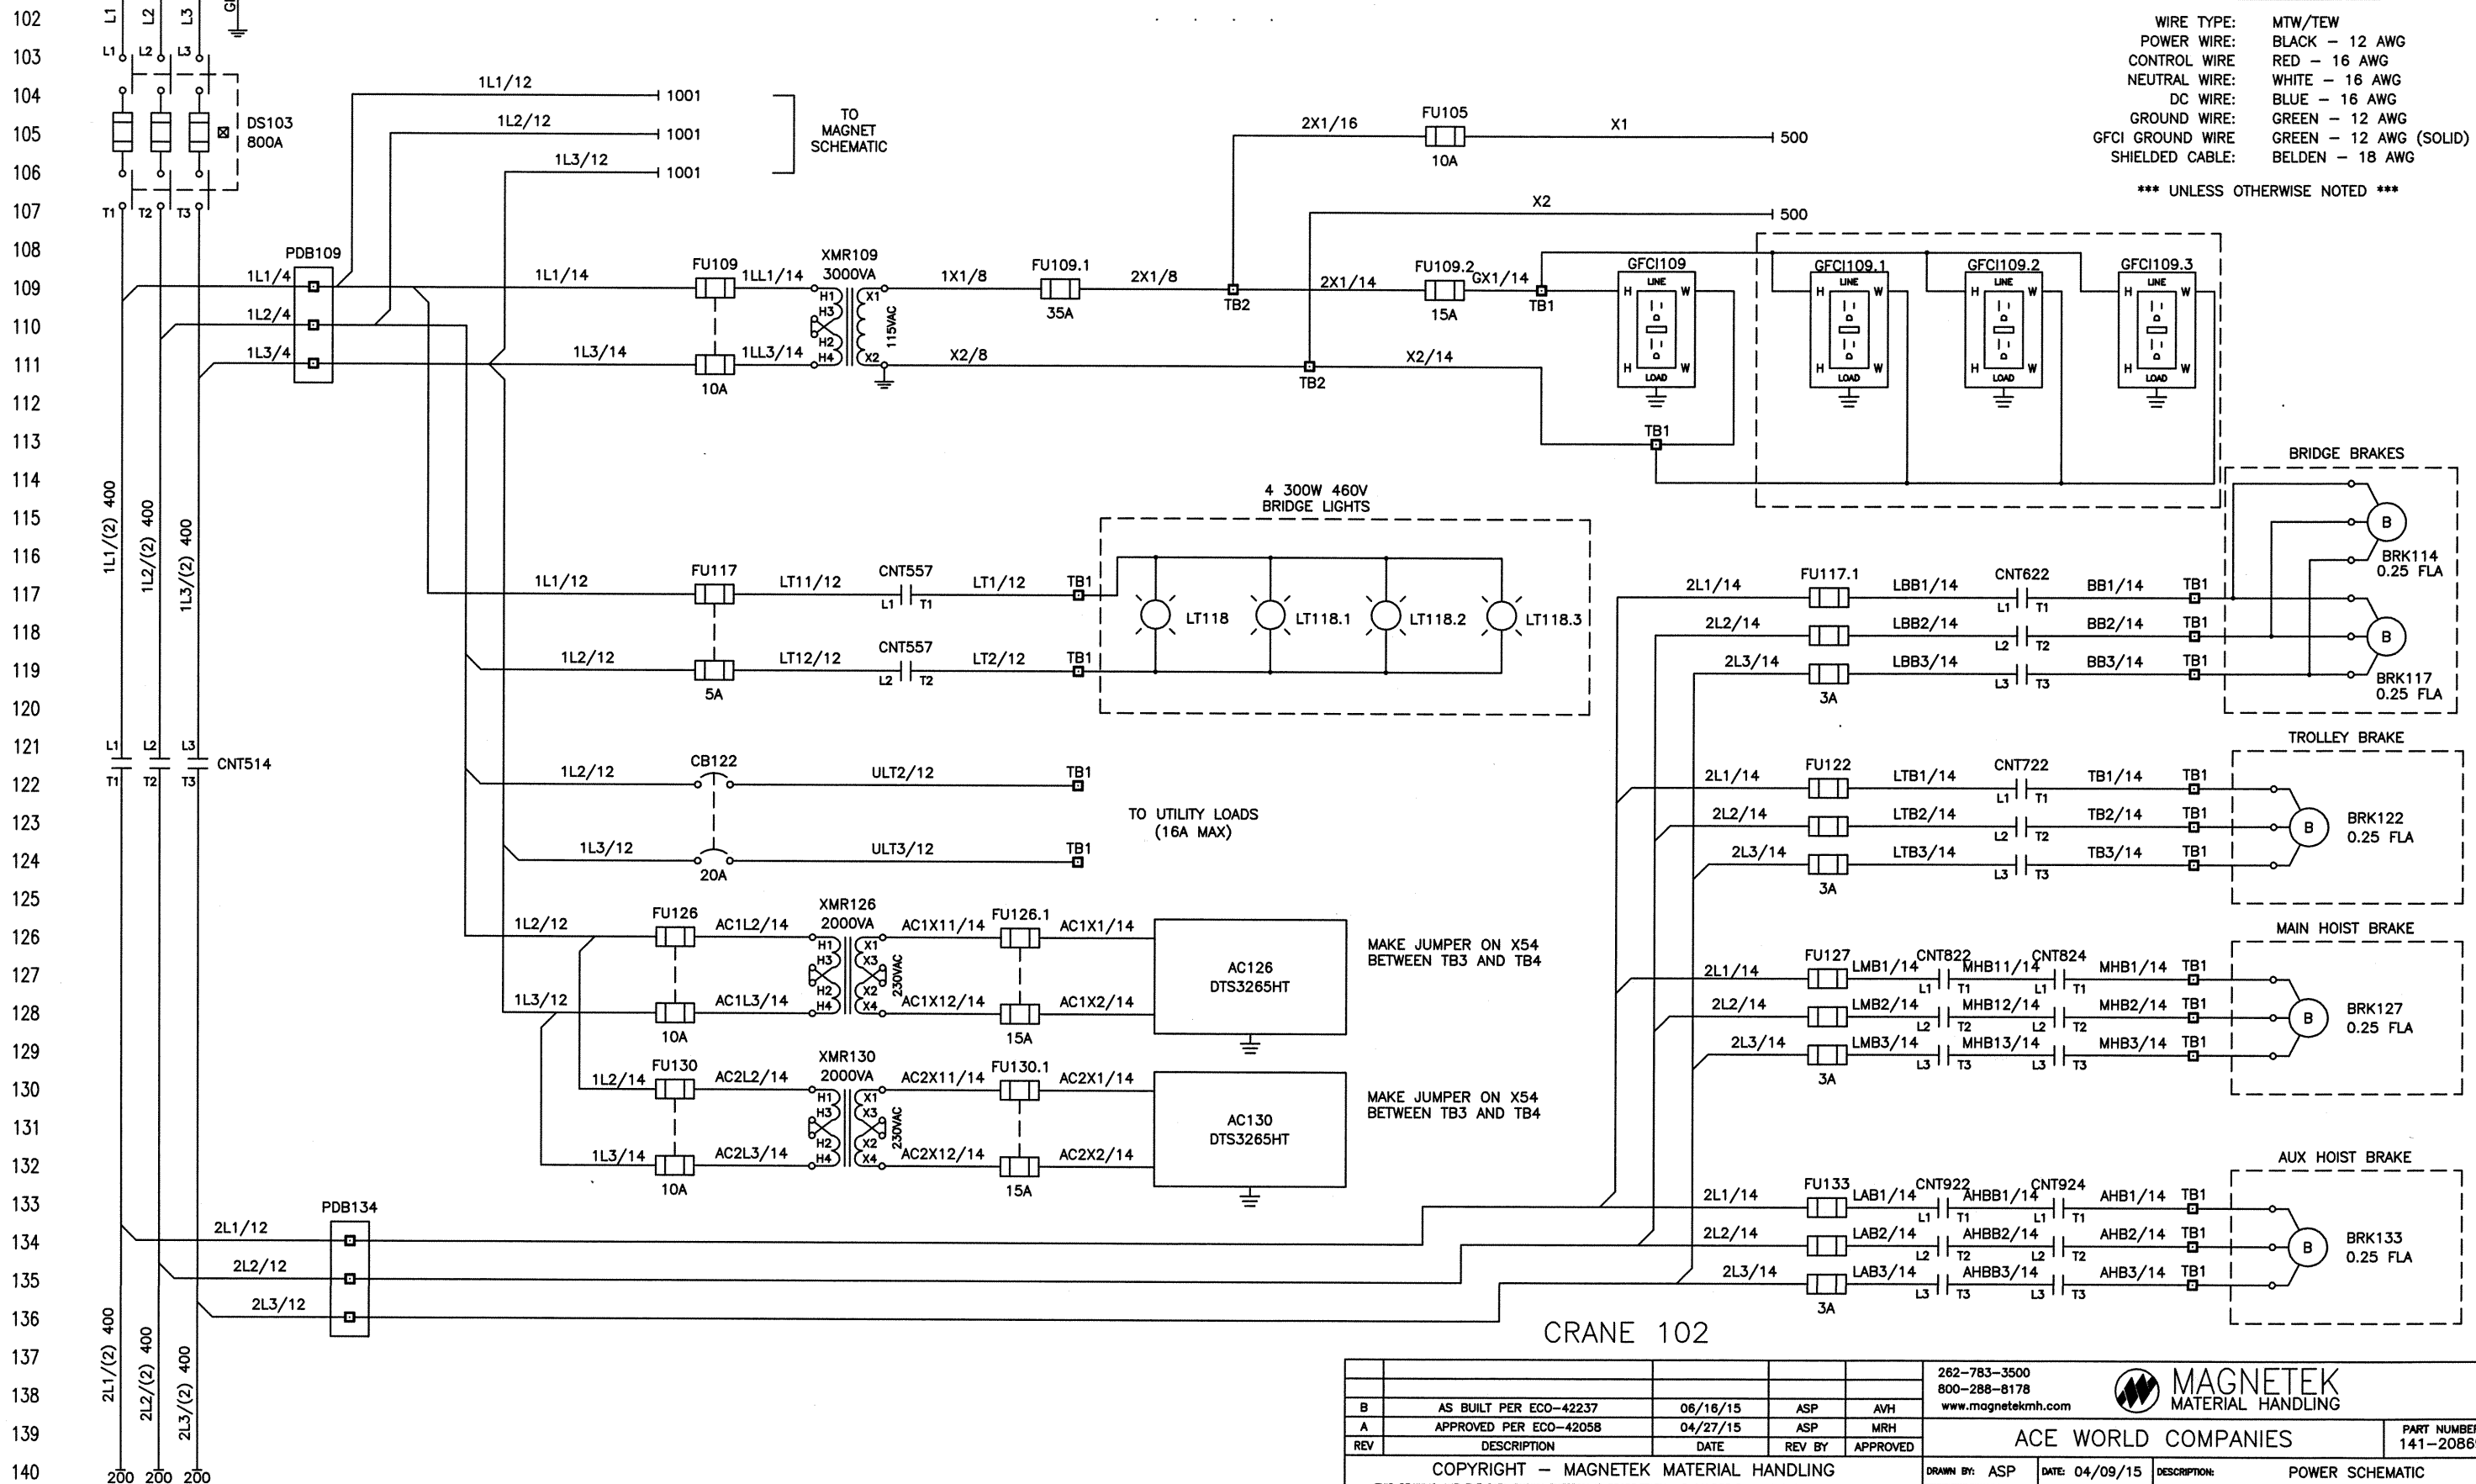

				262-783-3500 800-288-8178 www.magnetekmh.com			
B	AS BUILT PER ECO-42237	06/16/15	ASP	AVH			
A	APPROVED PER ECO-42058	04/27/15	ASP	MRH			
REV	DESCRIPTION	DATE	REV BY	APPROVED			
COPYRIGHT - MAGNETEK MATERIAL HANDLING					ACE WORLD COMPANIES		
THIS DRAWING AND THE DATA SHOWN THEREON IS PROPRIETARY AND CONFIDENTIAL AND THE SOLE PROPERTY OF MAGNETEK. DO NOT USE OR REPRODUCE FOR ANY PURPOSE WITHOUT THE WRITTEN CONSENT OF MAGNETEK					DRAWN BY: ASP	DATE: 04/09/15	DESCRIPTION: POWER SCHEMATIC
					CHECKED: AVH	APPROVED: SSP	DRAWING # 626388-00
					PAGE 1 OF 10		

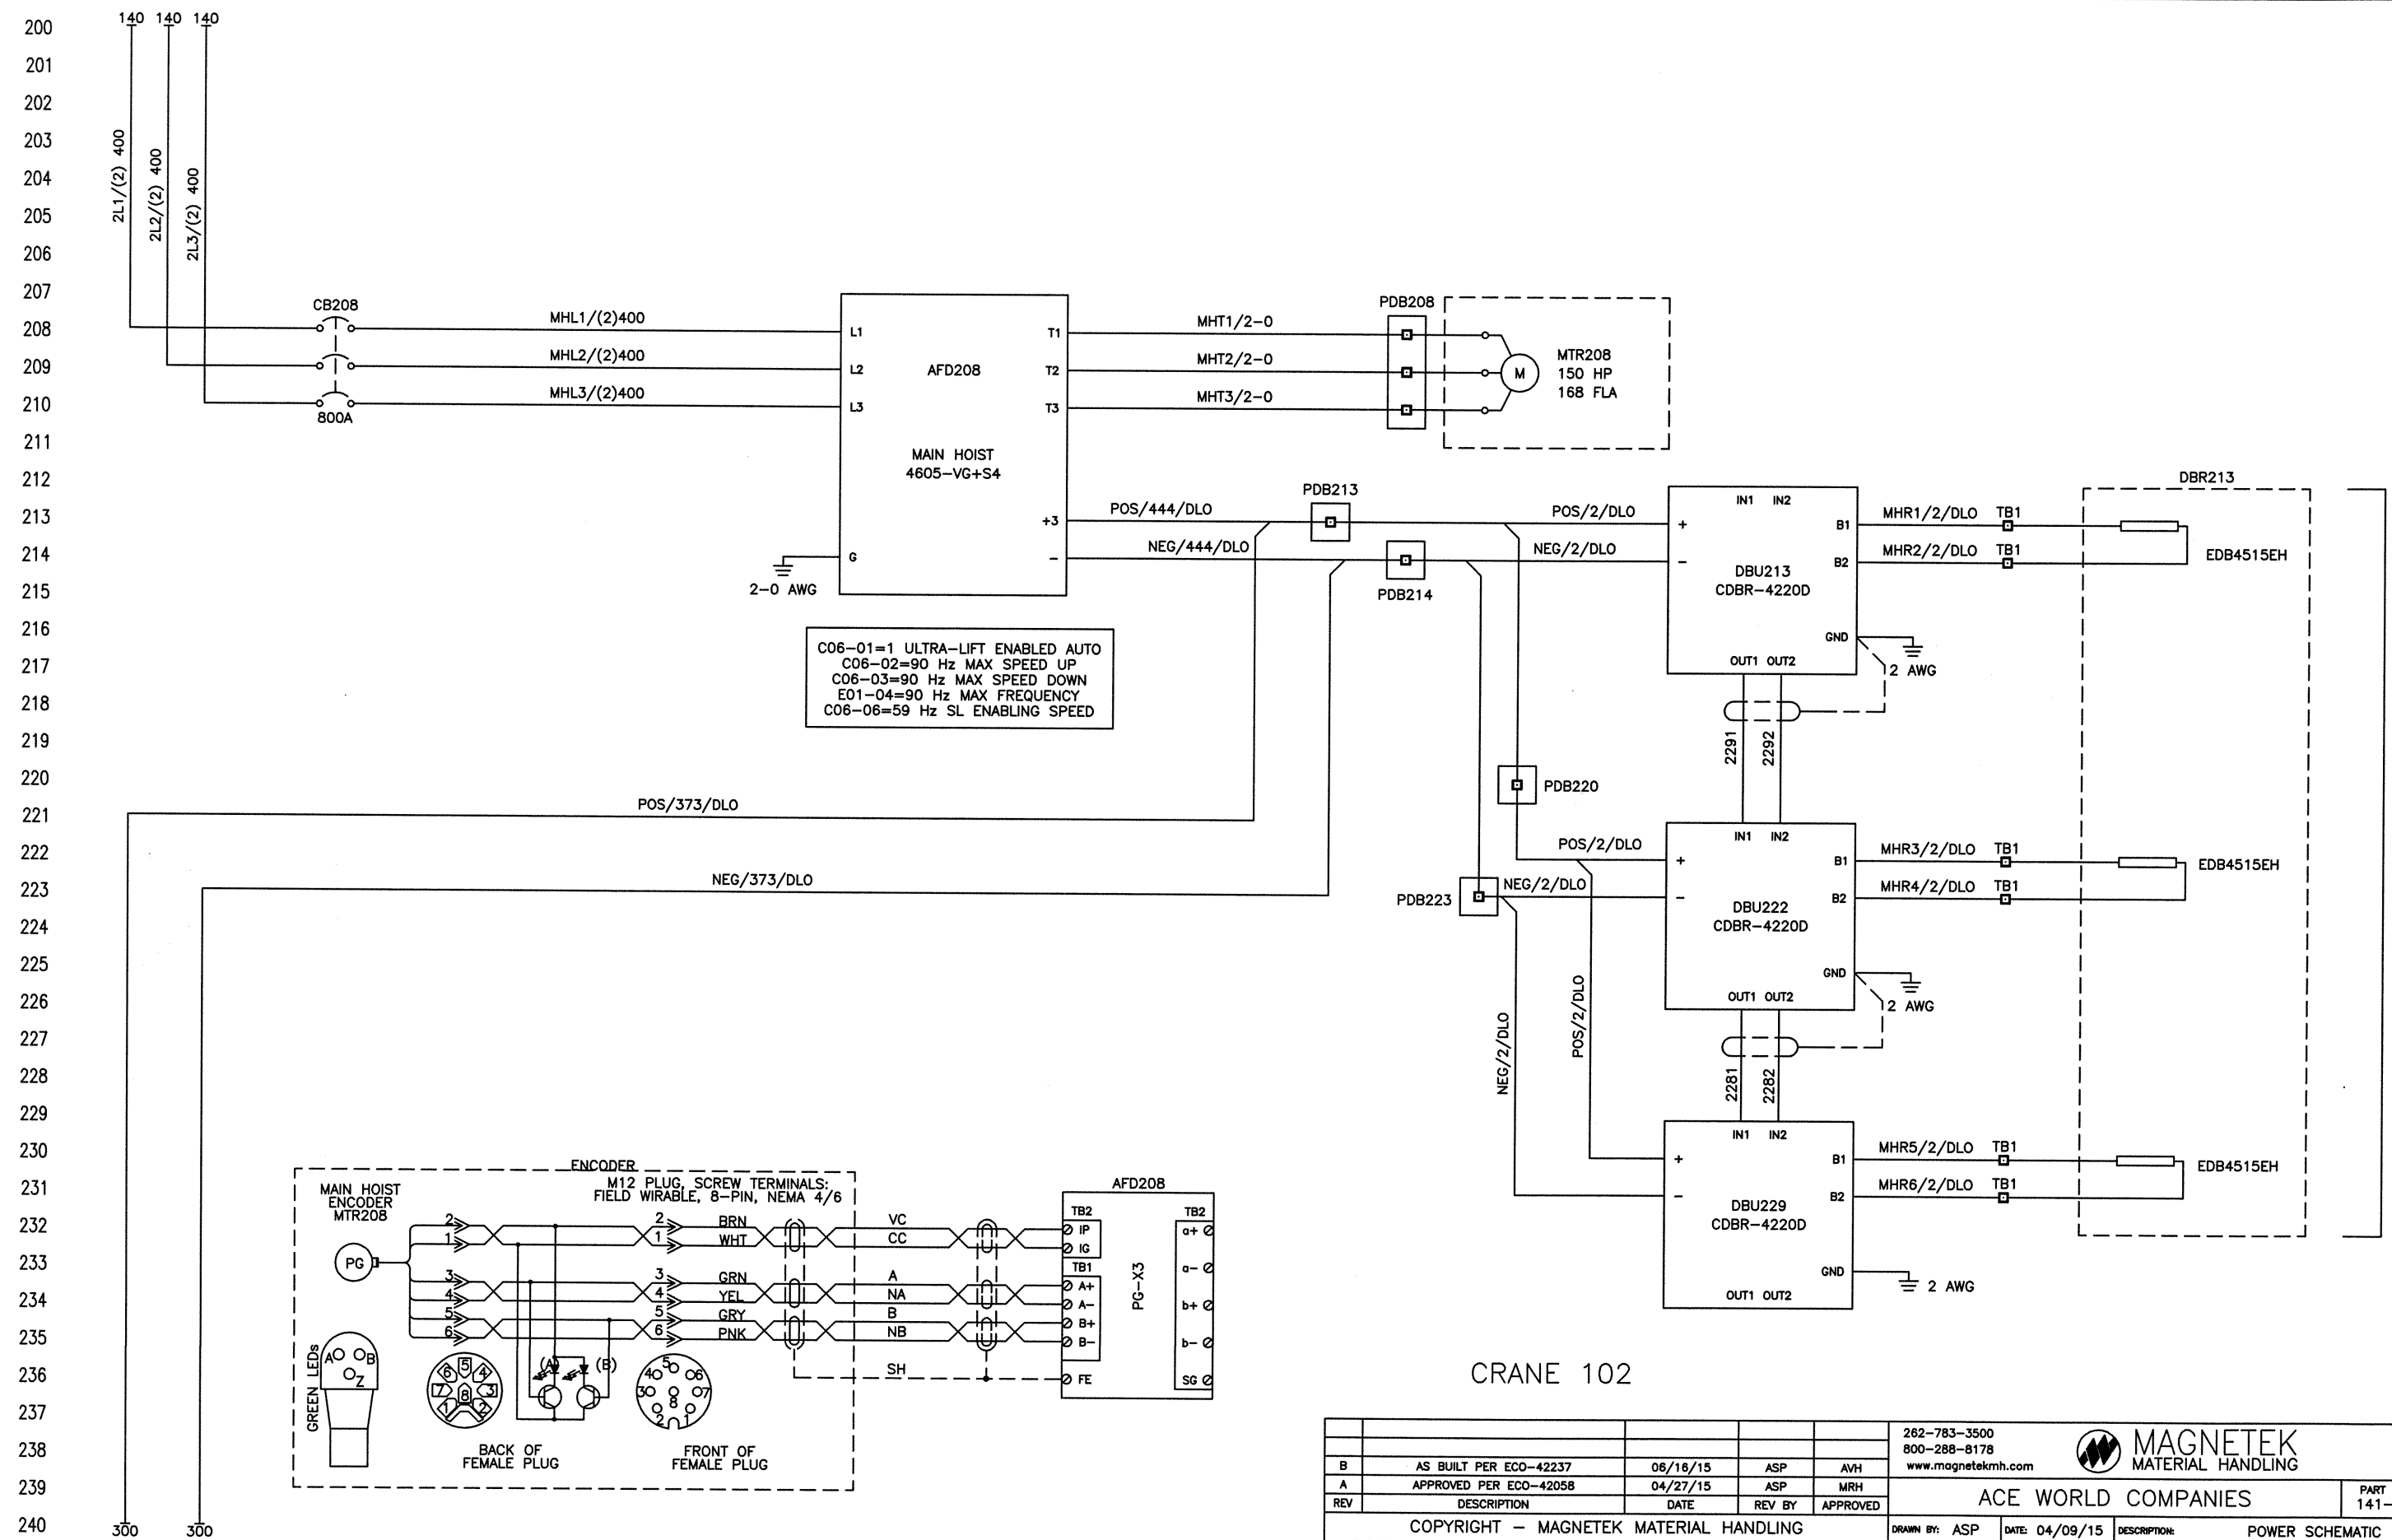

CRANE 102

					262-783-3500 800-288-8178 www.magnetekmh.com		MAGNETEK MATERIAL HANDLING	
B	AS BUILT PER ECO-42237	06/16/15	ASP	AVH				
A	APPROVED PER ECO-42058	04/27/15	ASP	MRH	ACE WORLD COMPANIES			PART NUMBER 141-20869
REV	DESCRIPTION	DATE	REV BY	APPROVED				
COPYRIGHT - MAGNETEK MATERIAL HANDLING						DRAWN BY: ASP DATE: 04/09/15 DESCRIPTION: POWER SCHEMATIC		
THIS DRAWING AND THE DATA SHOWN THEREON IS PROPRIETARY AND CONFIDENTIAL AND THE SOLE PROPERTY OF MAGNETEK. DO NOT USE OR REPRODUCE FOR ANY PURPOSE WITHOUT THE WRITTEN CONSENT OF MAGNETEK.						CHECKED: AVH APPROVED: SSP DRAWING # 626388-00 PAGE 2 OF 10		

400
401
402
340 340

C06-01=1 ULTRA-LIFT ENABLED AUTO
C06-02=90 Hz MAX SPEED UP
C06-03=90 Hz MAX SPEED DOWN
E01-04=90 Hz MAX FREQUENCY
C06-06=59 Hz SL ENABLING SPEED

POS/313/DLO

NEG/313/DLO

AHPOS1/313/DLO

CB407


AHPOS/313/DLO

AHNEG/313/DLO

AHNEG1/313/DLO

400A

4 AWG

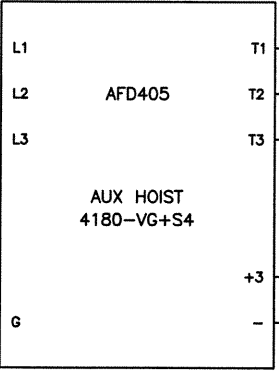

PDB405

AHT1/2-0


AHT2/2-0

AHT3/2-0

AHPOS/313/DLO



AHNEG/313/DLO


MTR405
150 HP
168 FLA

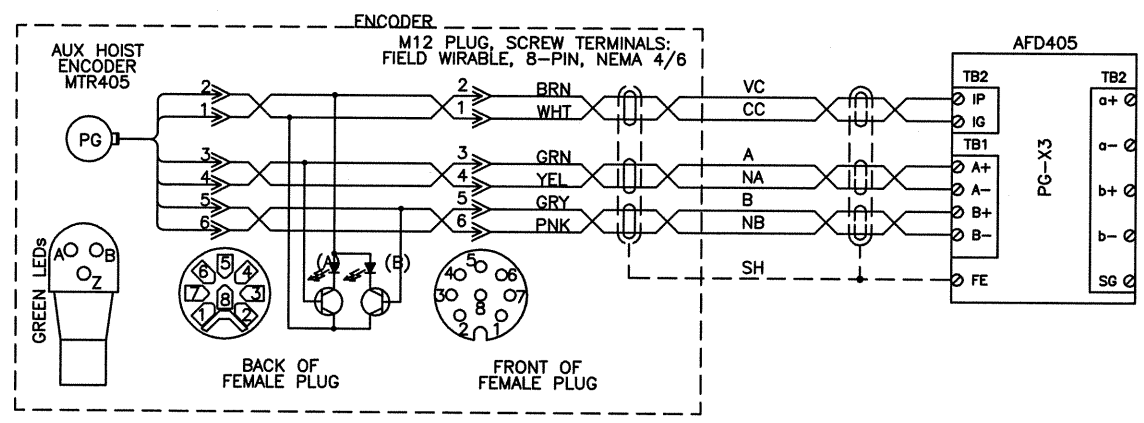


CRANE 102

						262-783-3500 800-288-8178 www.magnetekmh.com		 MAGNETEK MATERIAL HANDLING	
B	AS BUILT PER ECO-42237	06/16/15	ASP	AVH					
A	APPROVED PER ECO-42058	04/27/15	ASP	MRH					
REV	DESCRIPTION	DATE	REV BY	APPROVED	ACE WORLD COMPANIES				PART NUMBER 141-20869
COPYRIGHT - MAGNETEK MATERIAL HANDLING					DRAWN BY: ASP DATE: 04/09/15 DESCRIPTION: POWER SCHEMATIC				
THIS DRAWING AND THE DATA SHOWN THEREON IS PROPRIETARY AND CONFIDENTIAL AND THE SOLE PROPERTY OF MAGNETEK. DO NOT USE OR REPRODUCE FOR ANY PURPOSE WITHOUT THE WRITTEN CONSENT OF MAGNETEK					CHECKED: AVH APPROVED: SSP DRAWING # 626388-00 PAGE 4 OF 10				

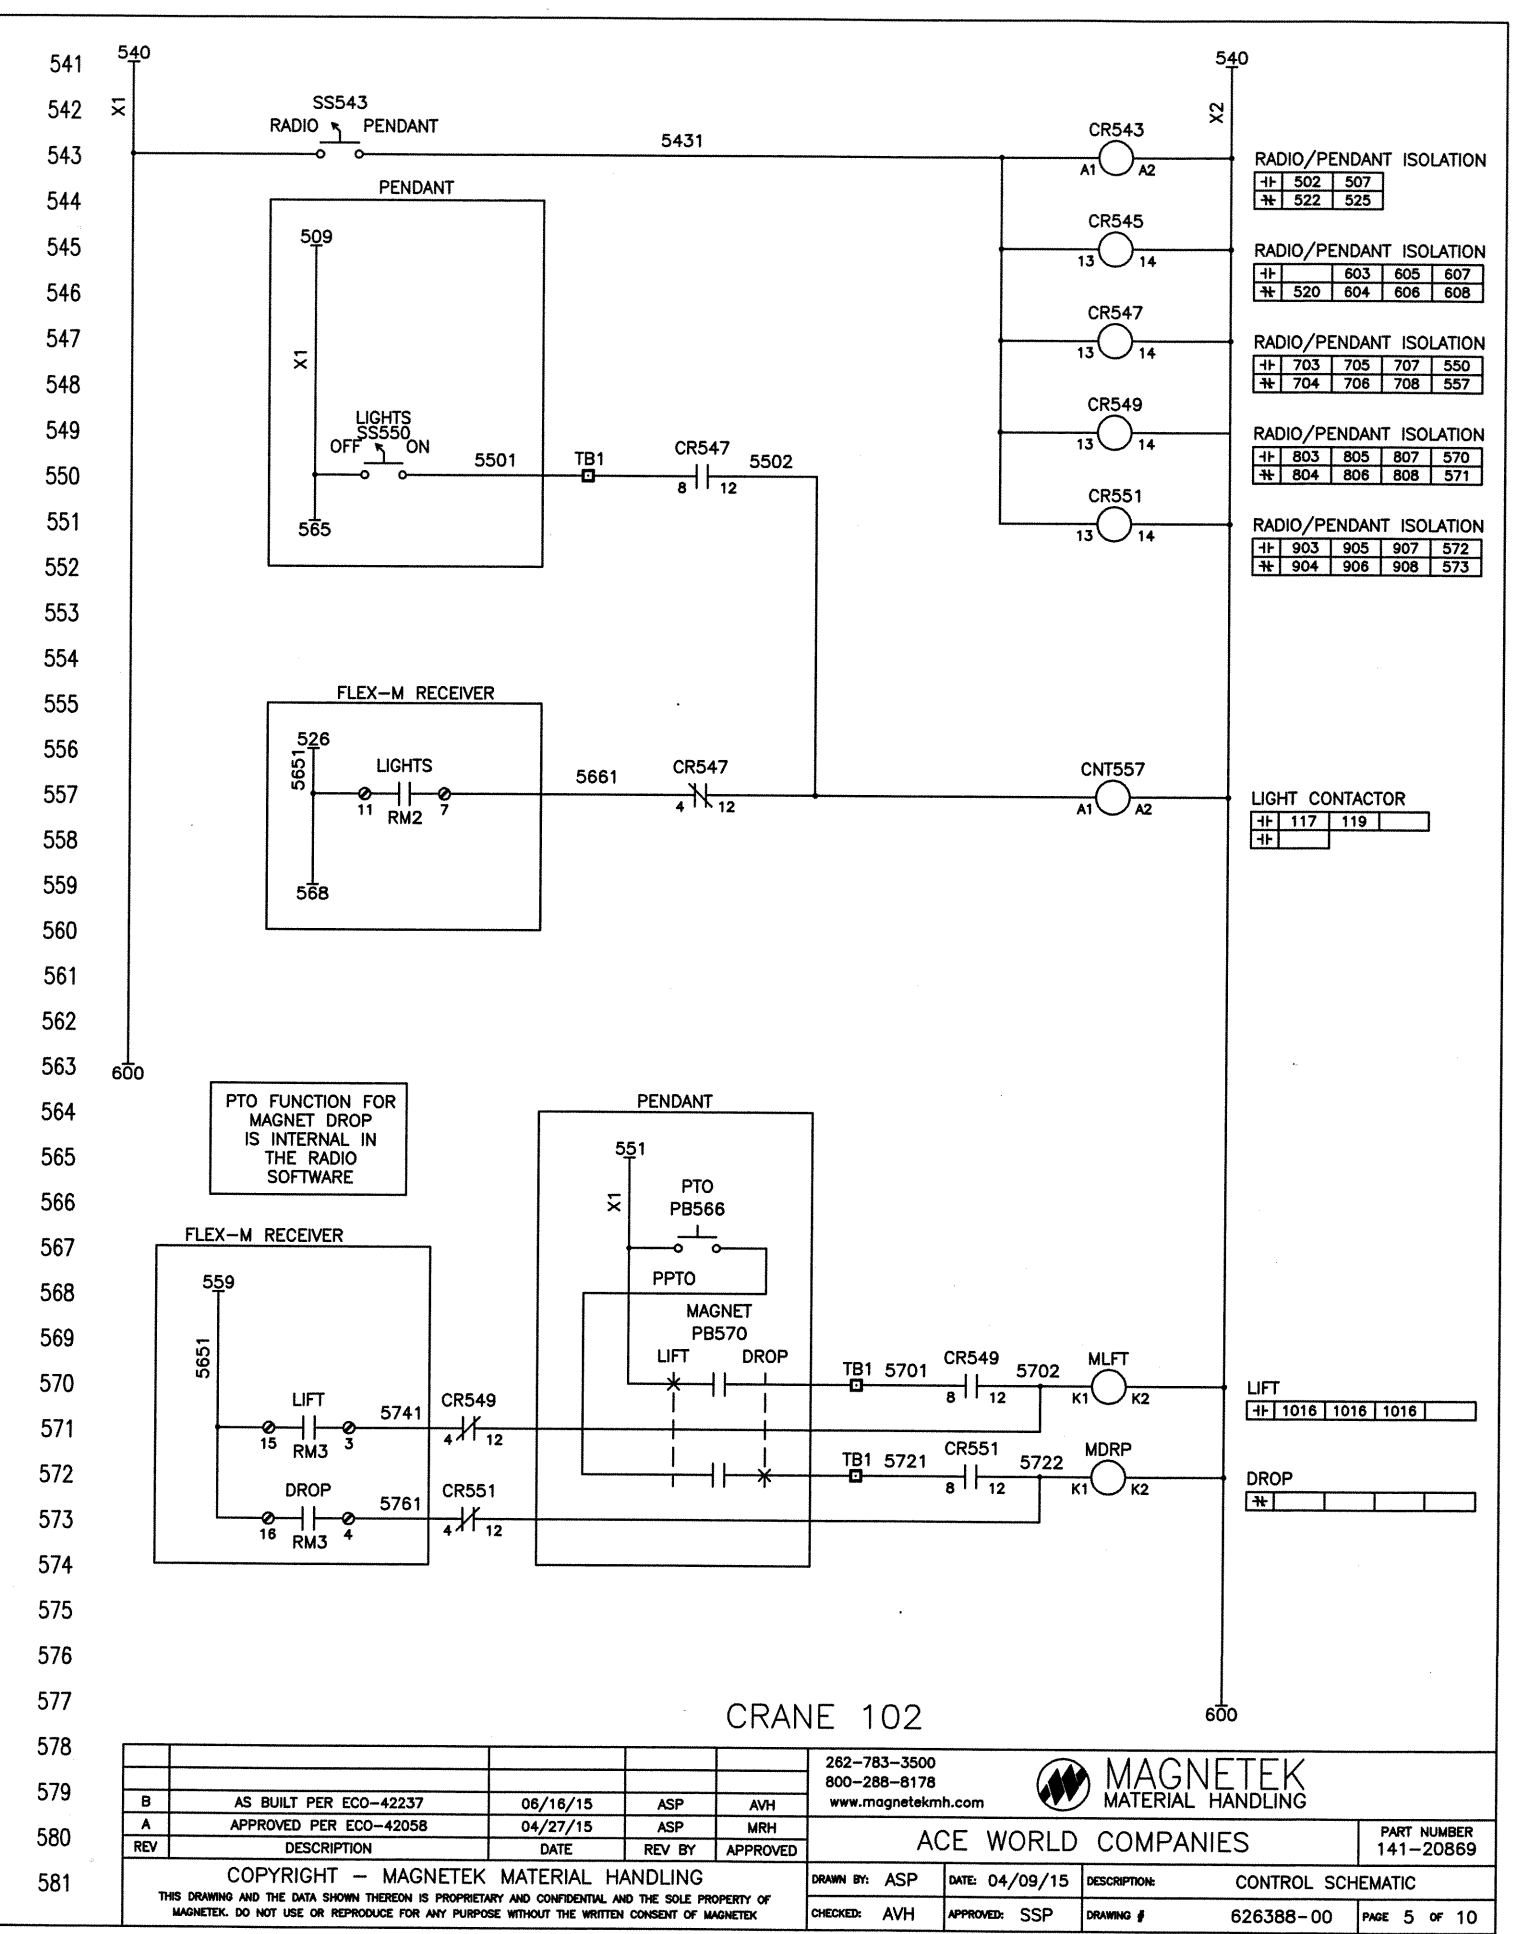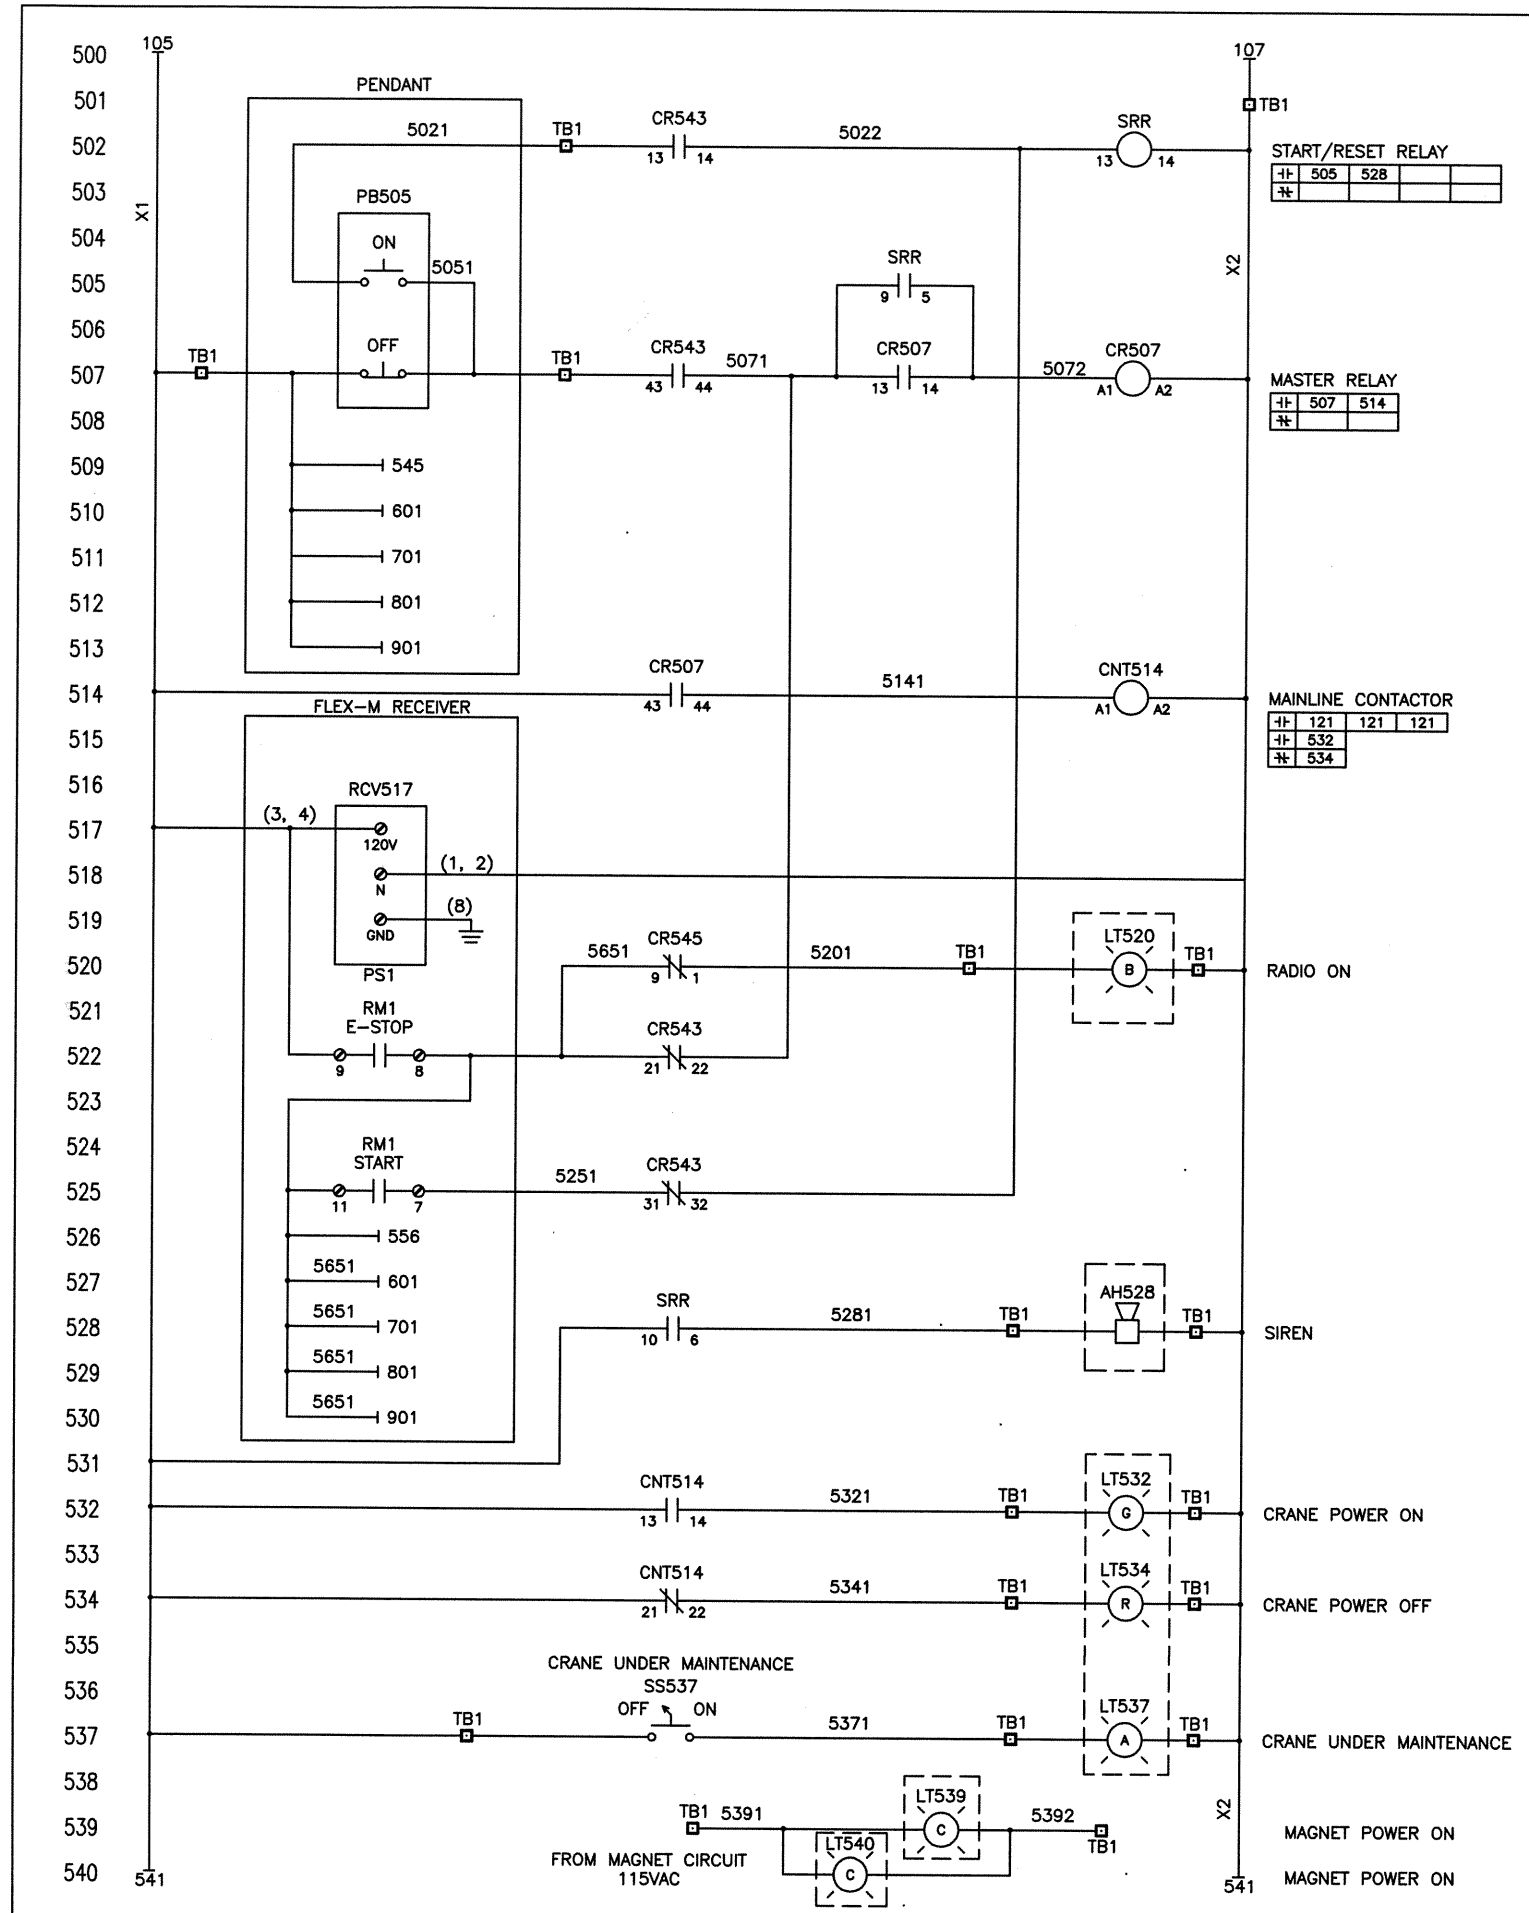


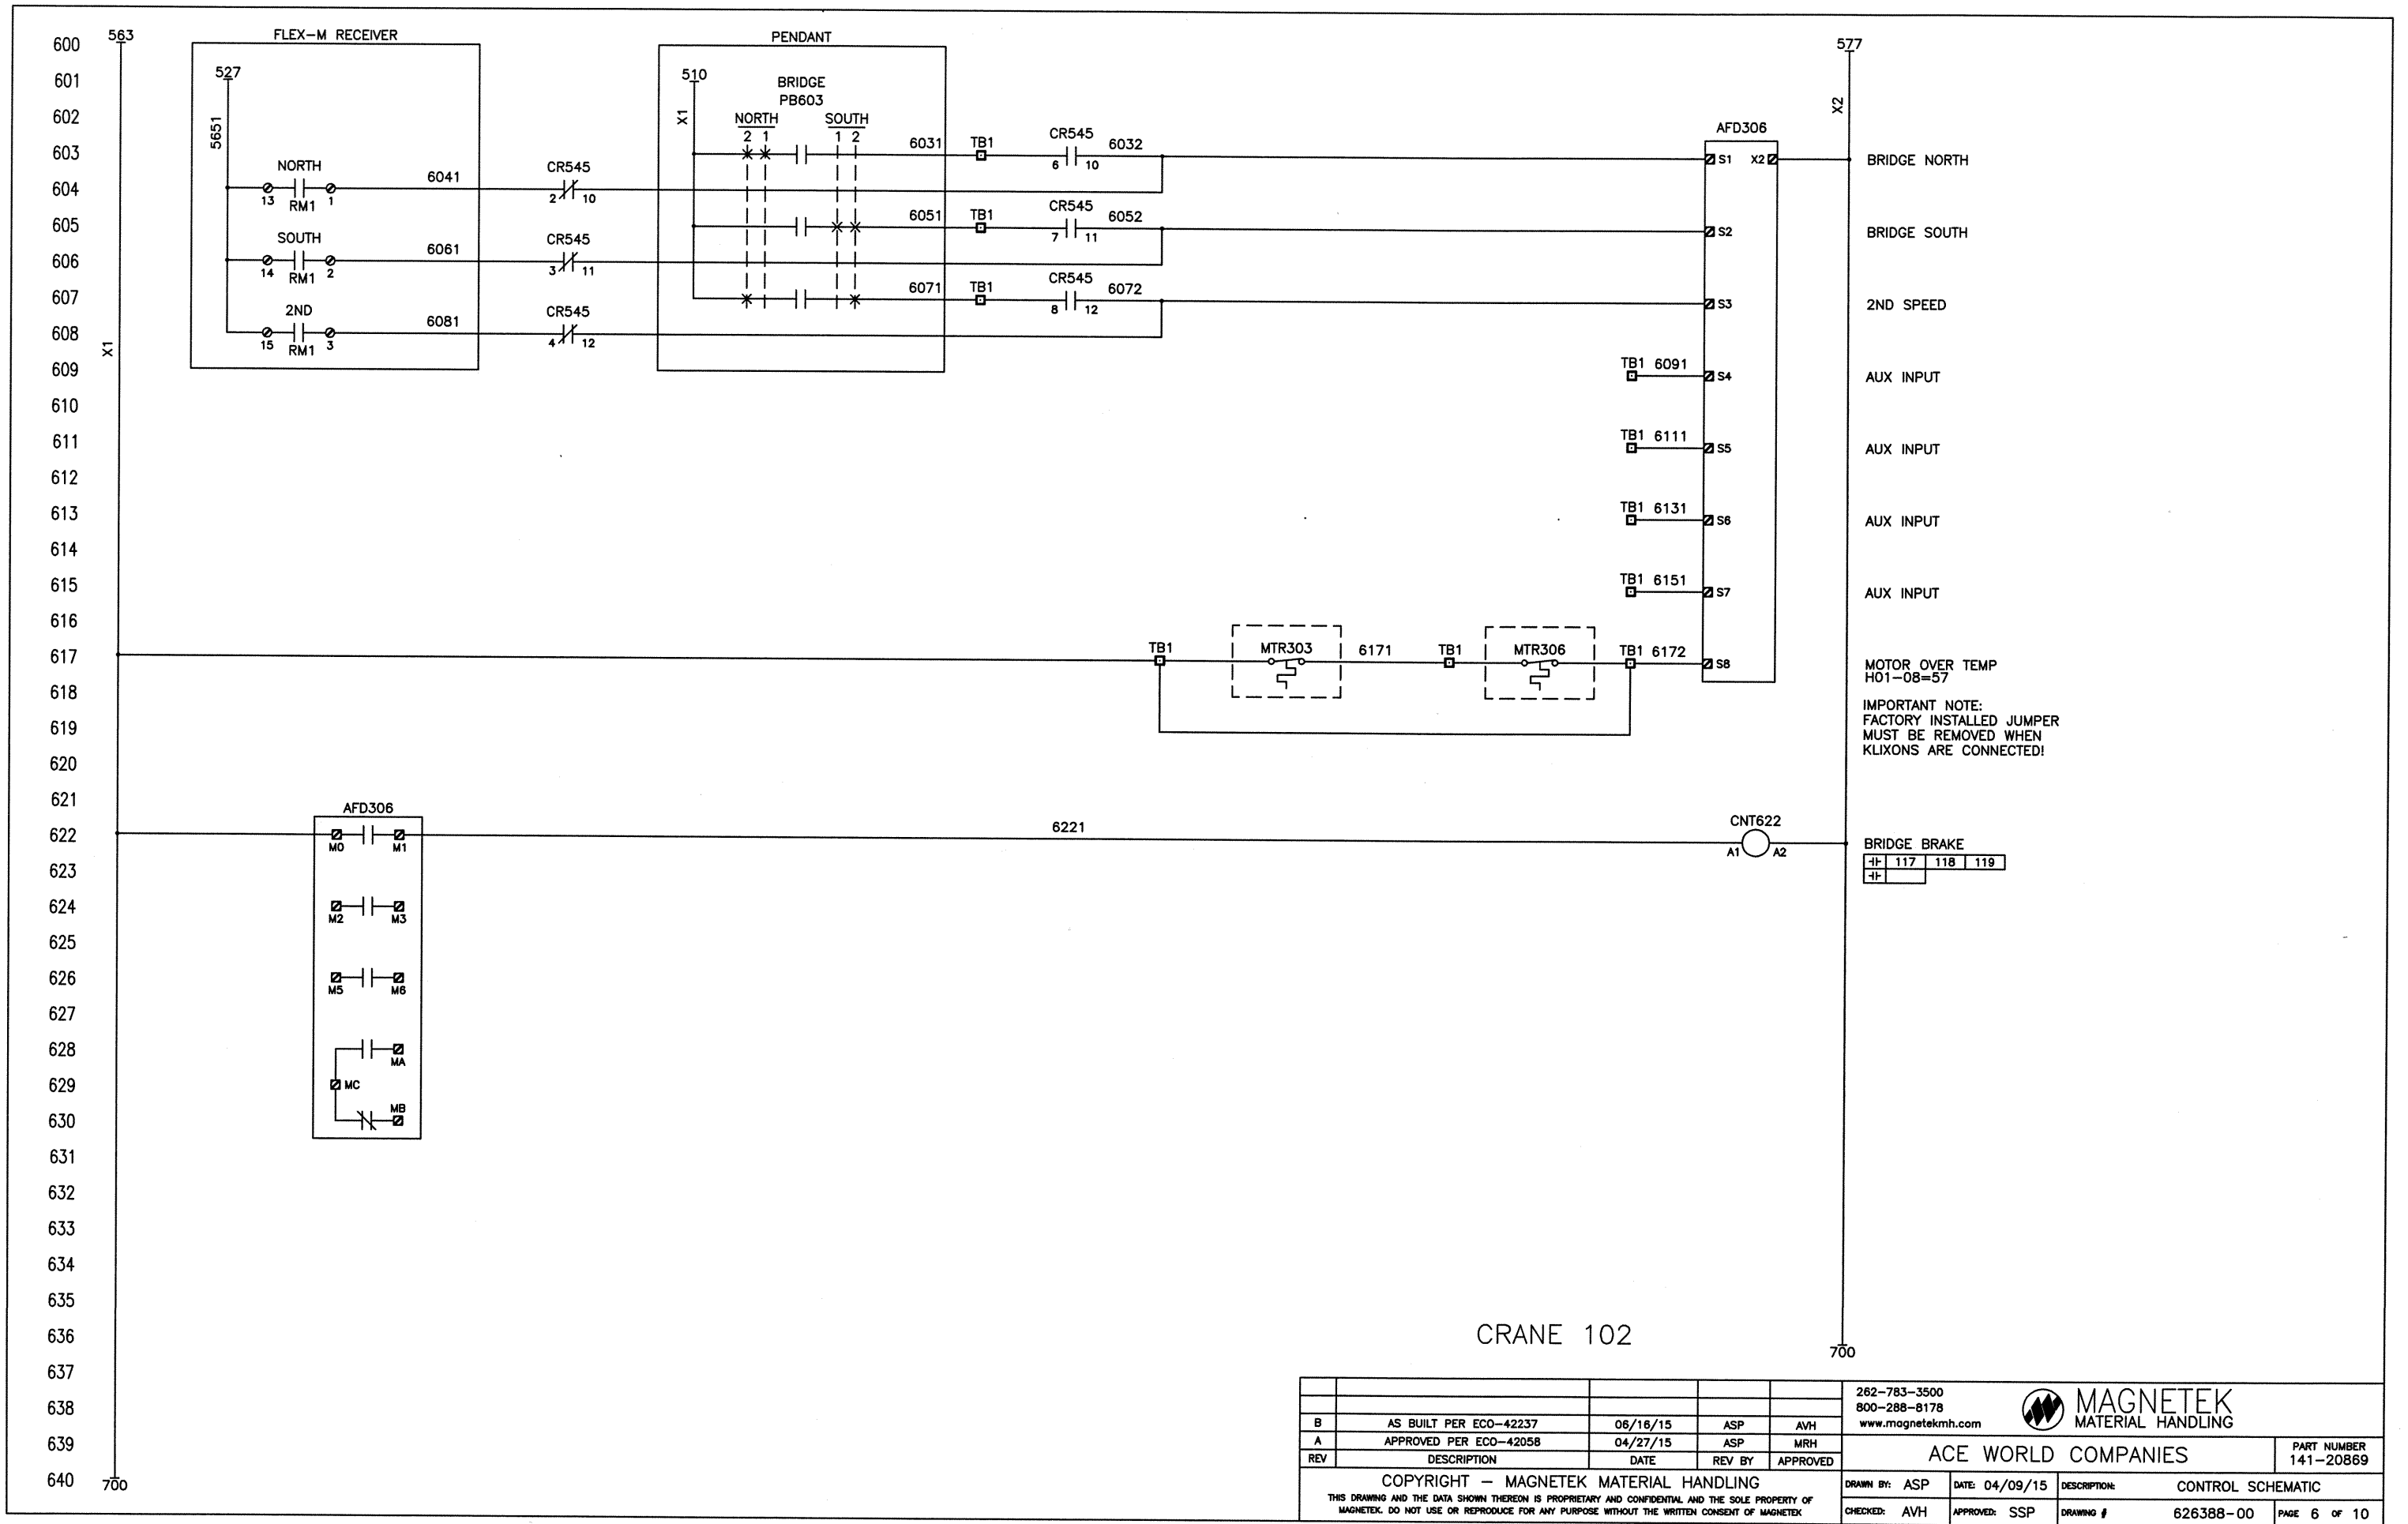

					262-783-3500 800-288-8178 www.magnetekmh.com			MAGNETEK MATERIAL HANDLING		
B	AS BUILT PER ECO-42237	06/16/15	ASP	AVH						
A	APPROVED PER ECO-42058	04/27/15	ASP	MRH	ACE WORLD COMPANIES					PART NUMBER 141-20869
REV	DESCRIPTION	DATE	REV BY	APPROVED						
COPYRIGHT — MAGNETEK MATERIAL HANDLING					DRAWN BY: ASP		DATE: 04/09/15	DESCRIPTION:	CONTROL SCHEMATIC	
THIS DRAWING AND THE DATA SHOWN THEREON IS PROPRIETARY AND CONFIDENTIAL AND THE SOLE PROPERTY OF MAGNETEK. DO NOT USE OR REPRODUCE FOR ANY PURPOSE WITHOUT THE WRITTEN CONSENT OF MAGNETEK					CHECKED: AVH		APPROVED: SSP	DRAWING #	626388-00	PAGE 6 OF 10

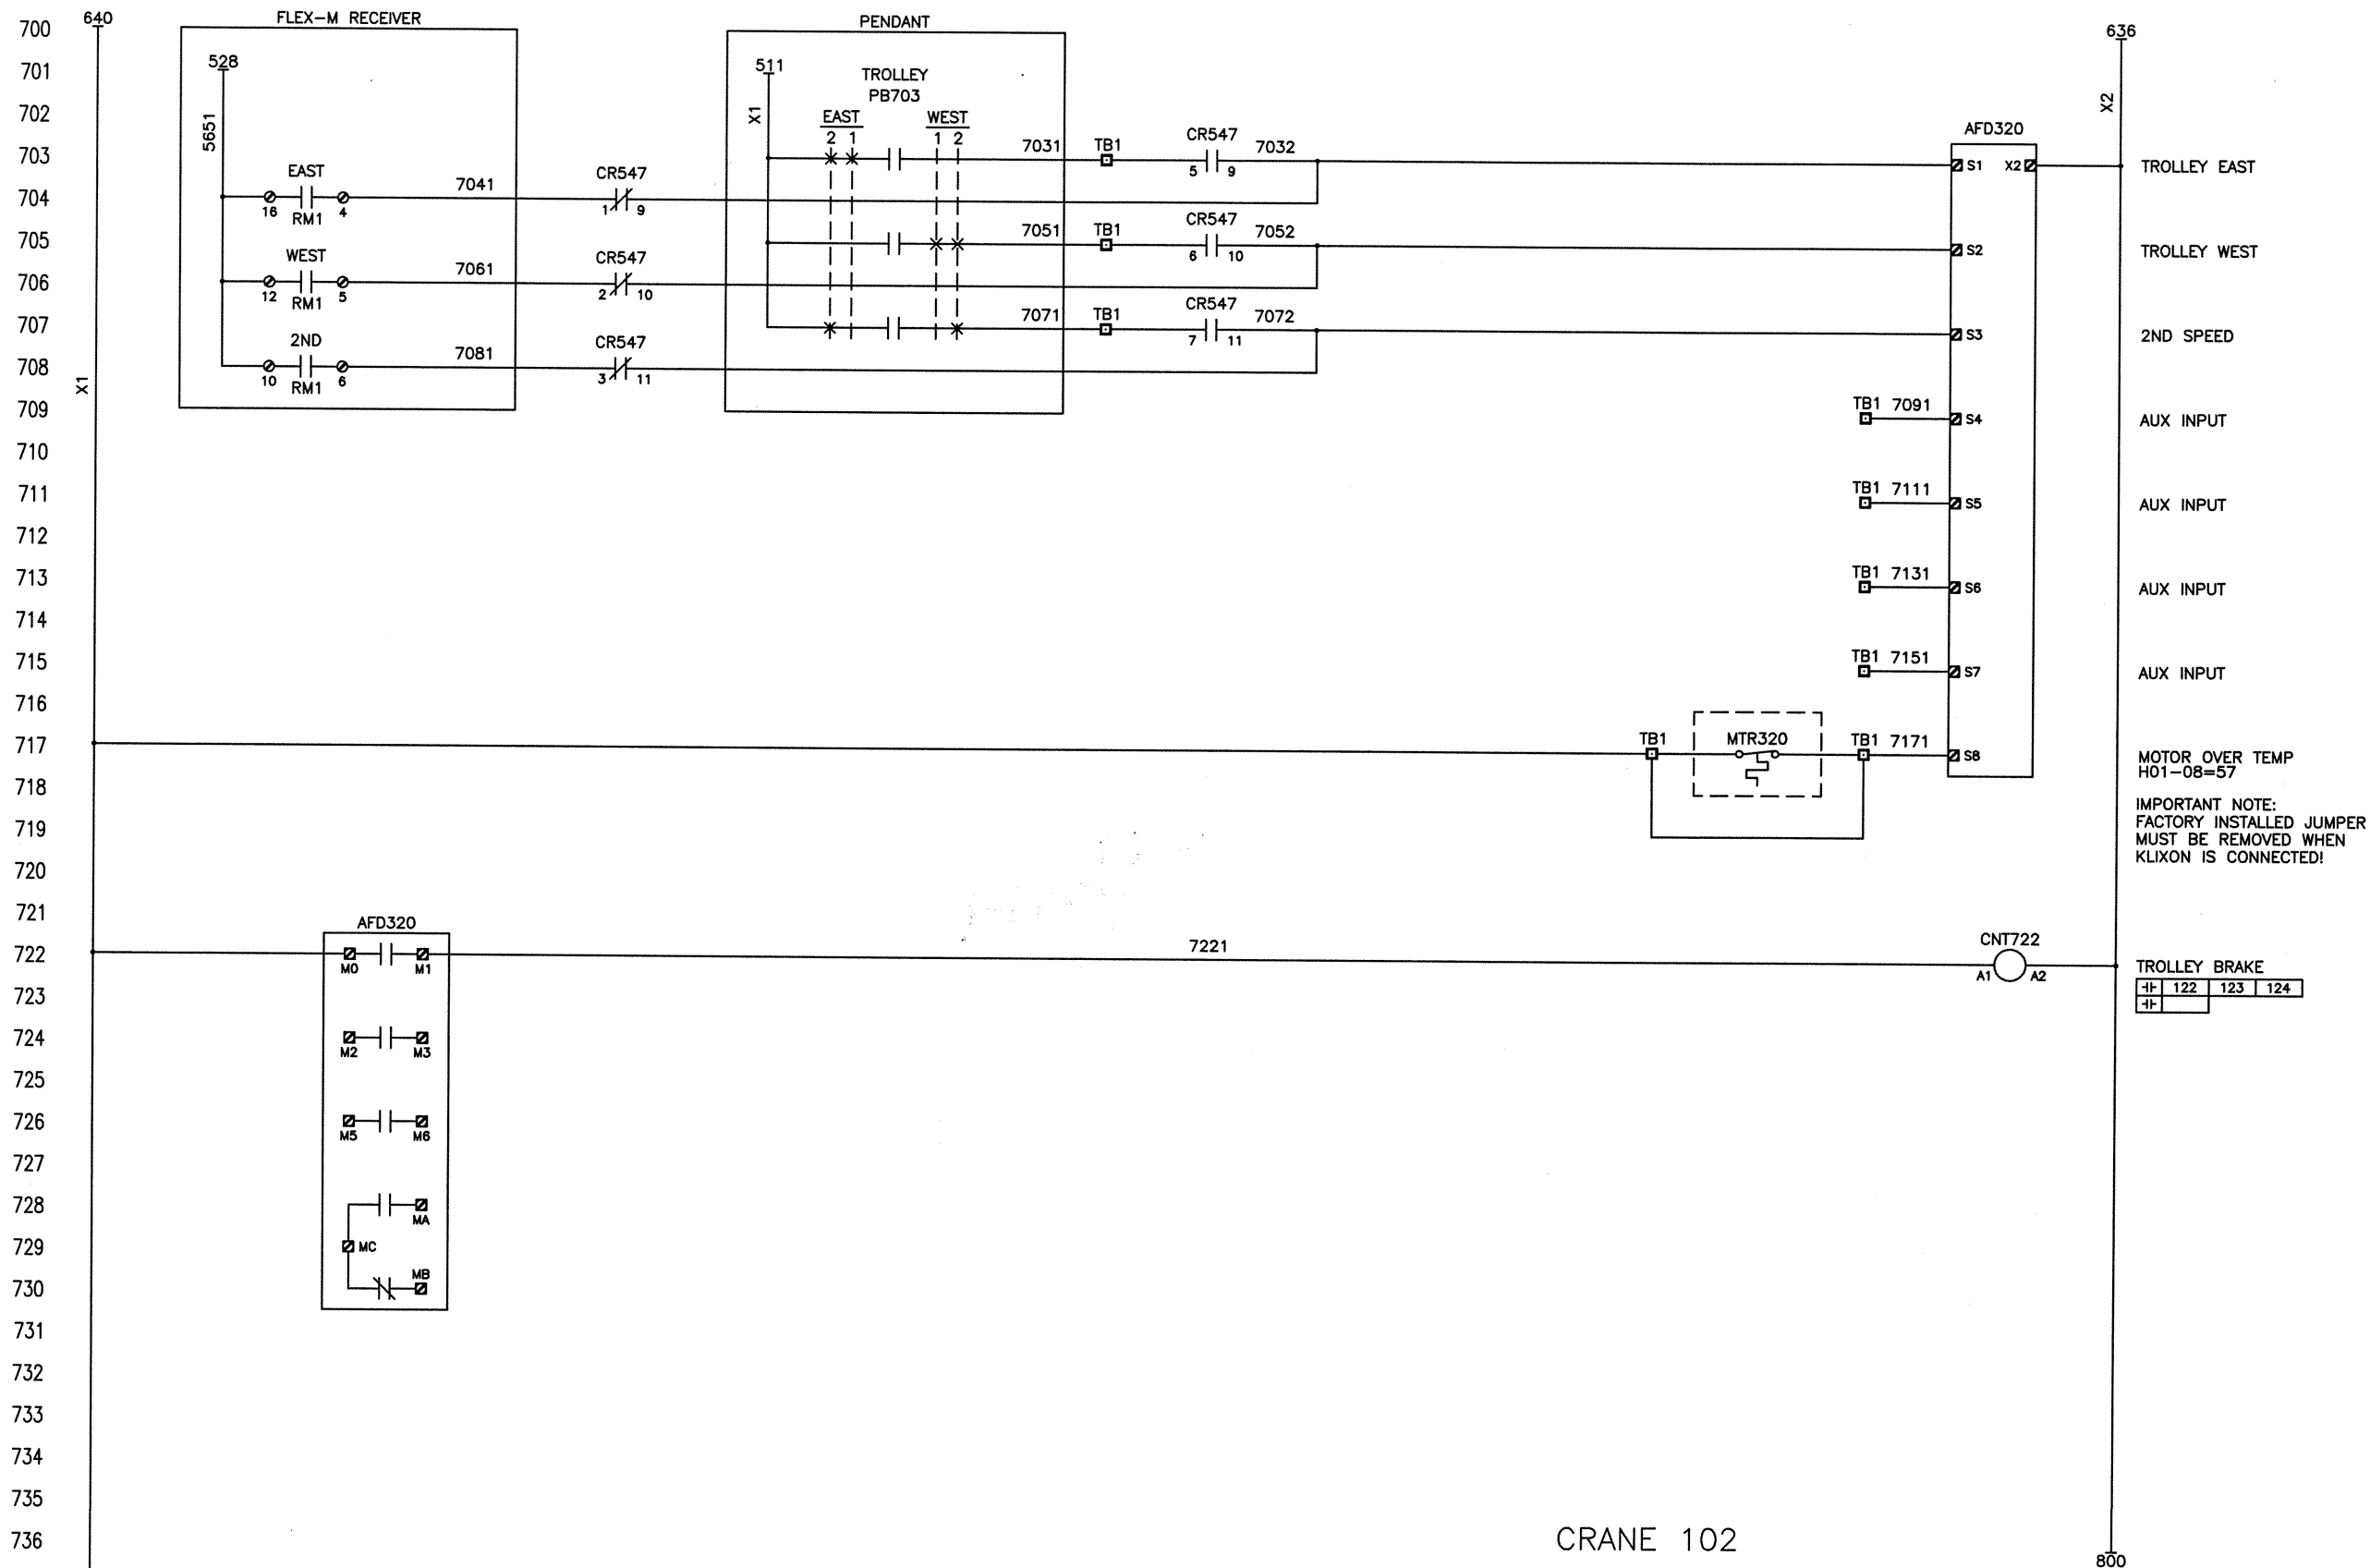


					262-783-3500 800-288-8178 www.magnetekmh.com			MAGNETEK MATERIAL HANDLING	
B	AS BUILT PER ECO-42237	06/16/15	ASP	AVH					
A	APPROVED PER ECO-42058	04/27/15	ASP	MRH					
REV	DESCRIPTION	DATE	REV BY	APPROVED	ACE WORLD COMPANIES				PART NUMBER 141-20869
COPYRIGHT - MAGNETEK MATERIAL HANDLING THIS DRAWING AND THE DATA SHOWN THEREON IS PROPRIETARY AND CONFIDENTIAL AND THE SOLE PROPERTY OF MAGNETEK. DO NOT USE OR REPRODUCE FOR ANY PURPOSE WITHOUT THE WRITTEN CONSENT OF MAGNETEK					DRAWN BY: ASP	DATE: 04/09/15	DESCRIPTION:	CONTROL SCHEMATIC	
					CHECKED: AVH	APPROVED: SSP	DRAWING #	626388-00	PAGE 7 OF 10

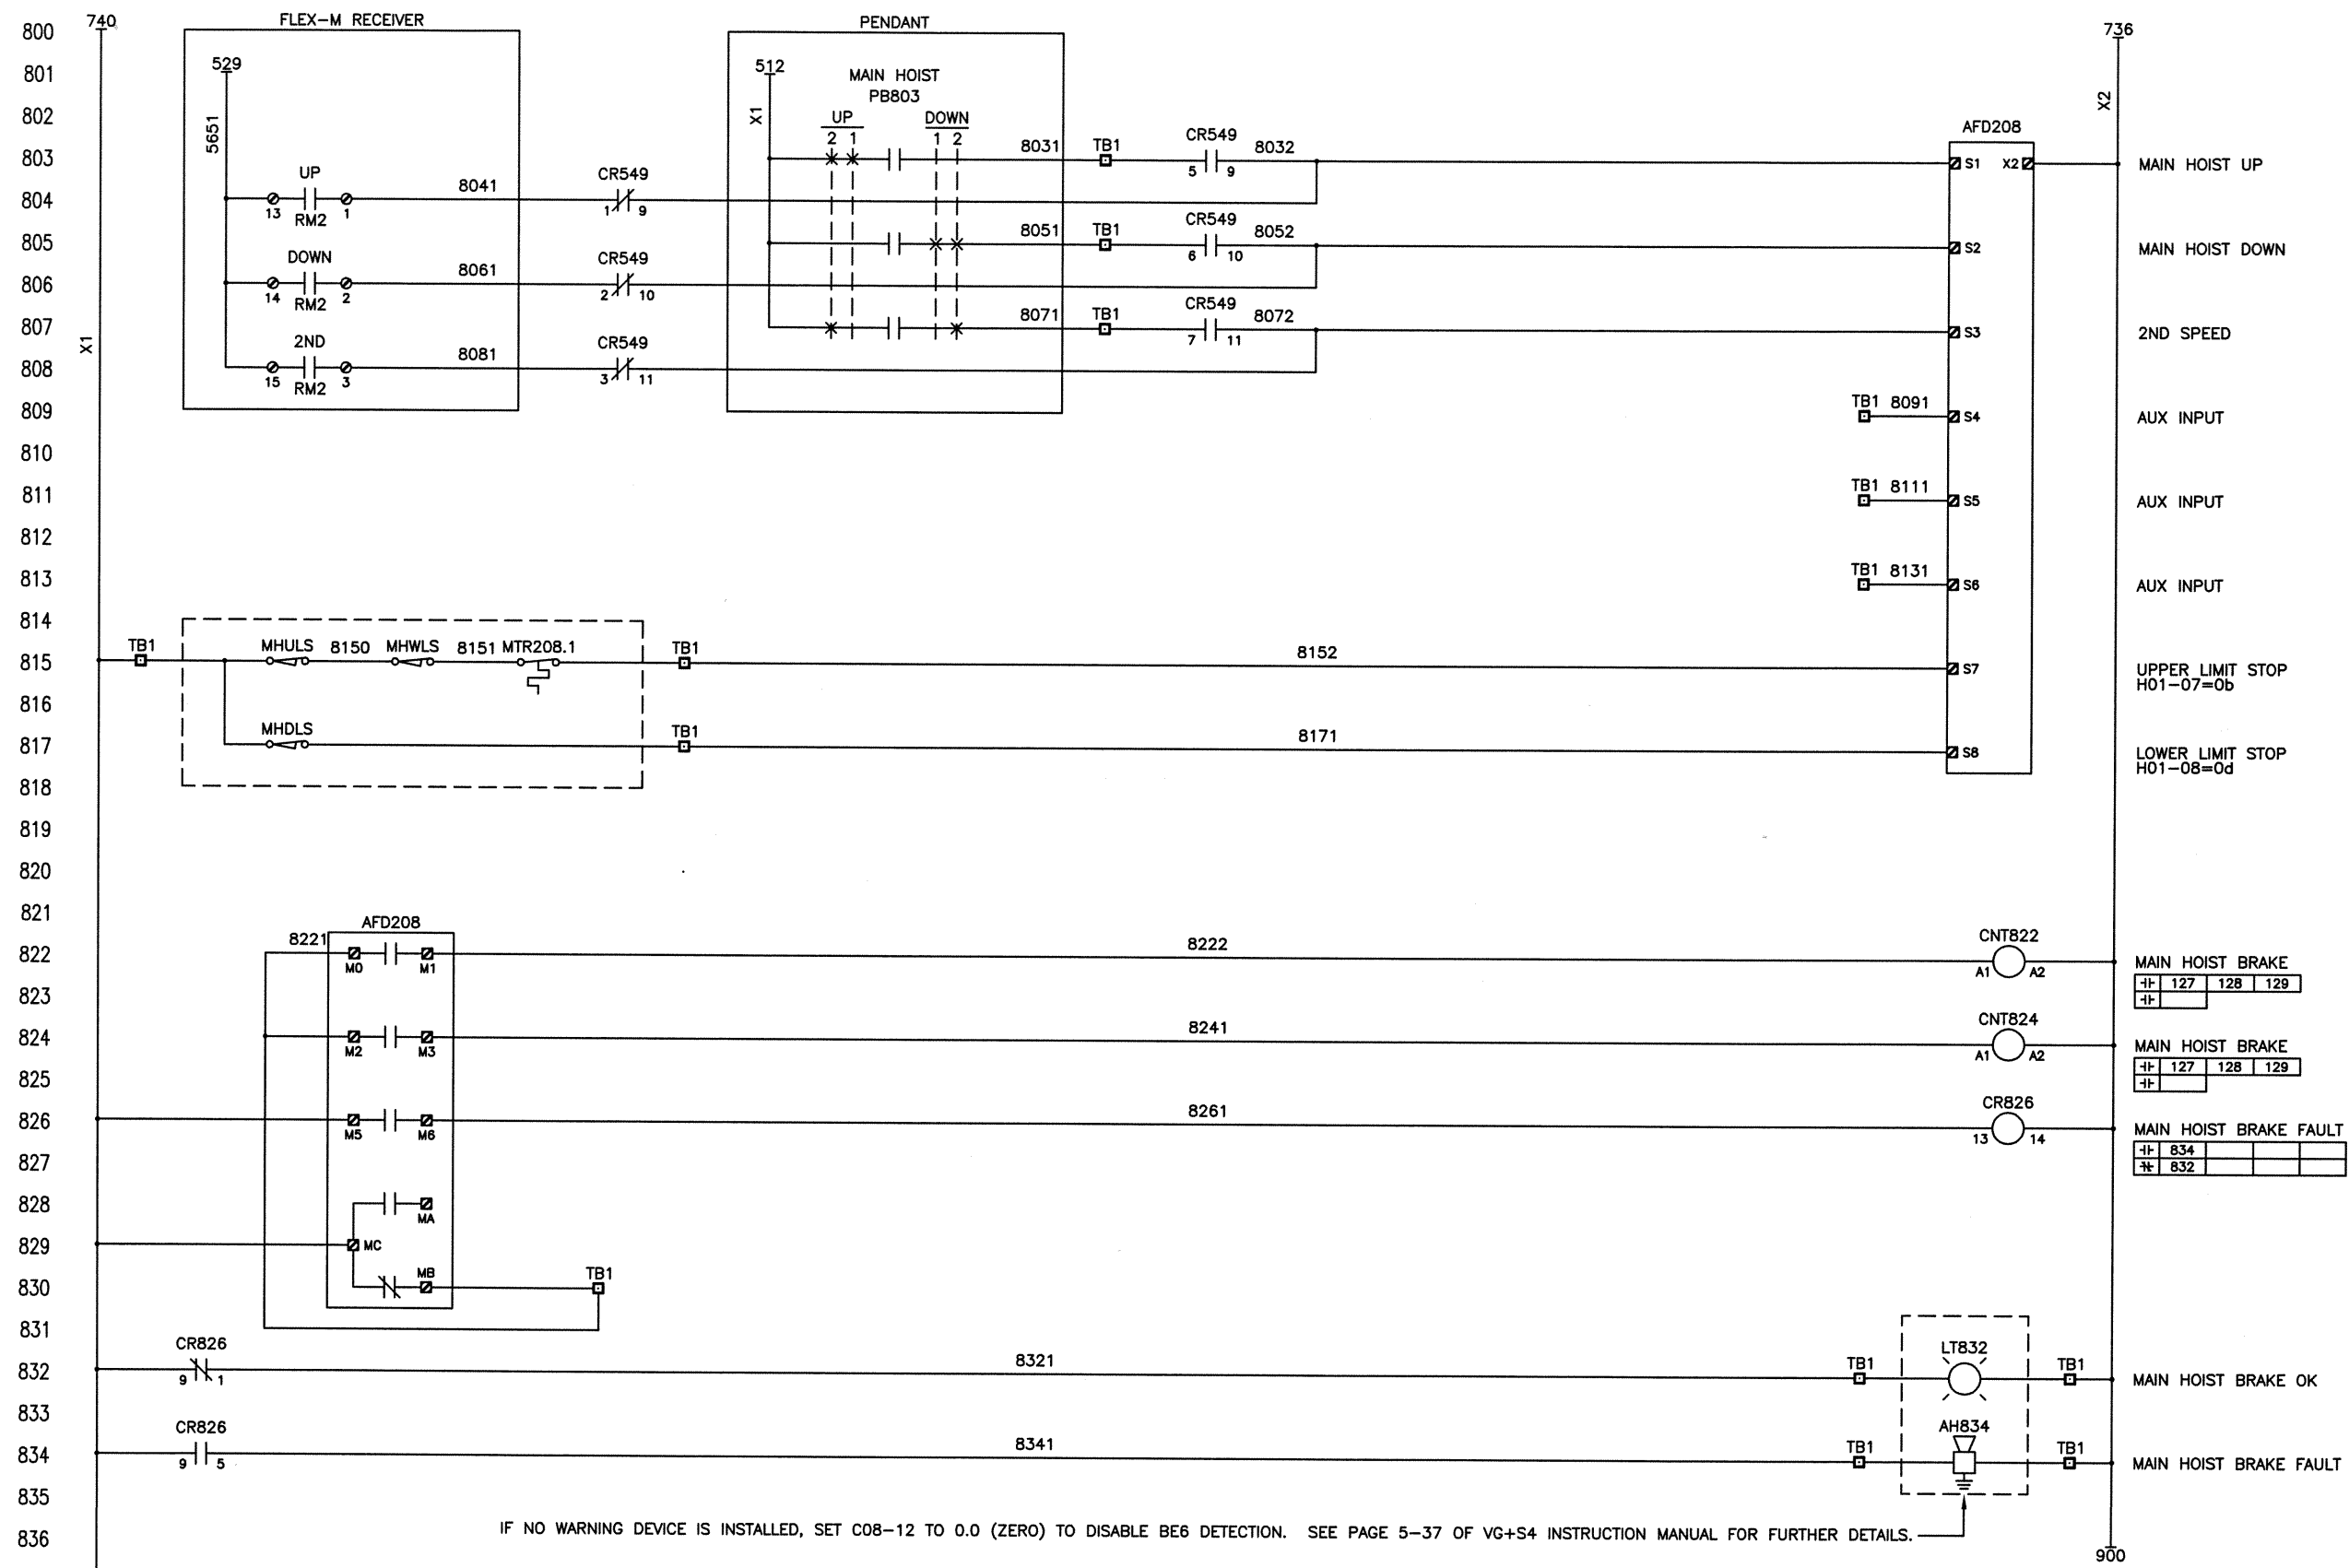

IF NO WARNING DEVICE IS INSTALLED, SET C08-12 TO 0.0 (ZERO) TO DISABLE BE6 DETECTION. SEE PAGE 5-37 OF VG+S4 INSTRUCTION MANUAL FOR FURTHER DETAILS.

CRANE 102


					262-783-3500 800-288-8178 www.magnetekmh.com			MAGNETEK MATERIAL HANDLING			
B	AS BUILT PER ECO-42237	06/16/15	ASP	AVH							
A	APPROVED PER ECO-42058	04/27/15	ASP	MRH	ACE WORLD COMPANIES					PART NUMBER 141-20869	
REV	DESCRIPTION	DATE	REV BY	APPROVED							
COPYRIGHT - MAGNETEK MATERIAL HANDLING					DRAWN BY: ASP		DATE: 04/09/15	DESCRIPTION:	CONTROL SCHEMATIC		
THIS DRAWING AND THE DATA SHOWN THEREON IS PROPRIETARY AND CONFIDENTIAL AND THE SOLE PROPERTY OF MAGNETEK. DO NOT USE OR REPRODUCE FOR ANY PURPOSE WITHOUT THE WRITTEN CONSENT OF MAGNETEK					CHECKED: AVH		APPROVED: SSP	DRAWING #	626388-00		PAGE 8 OF 10

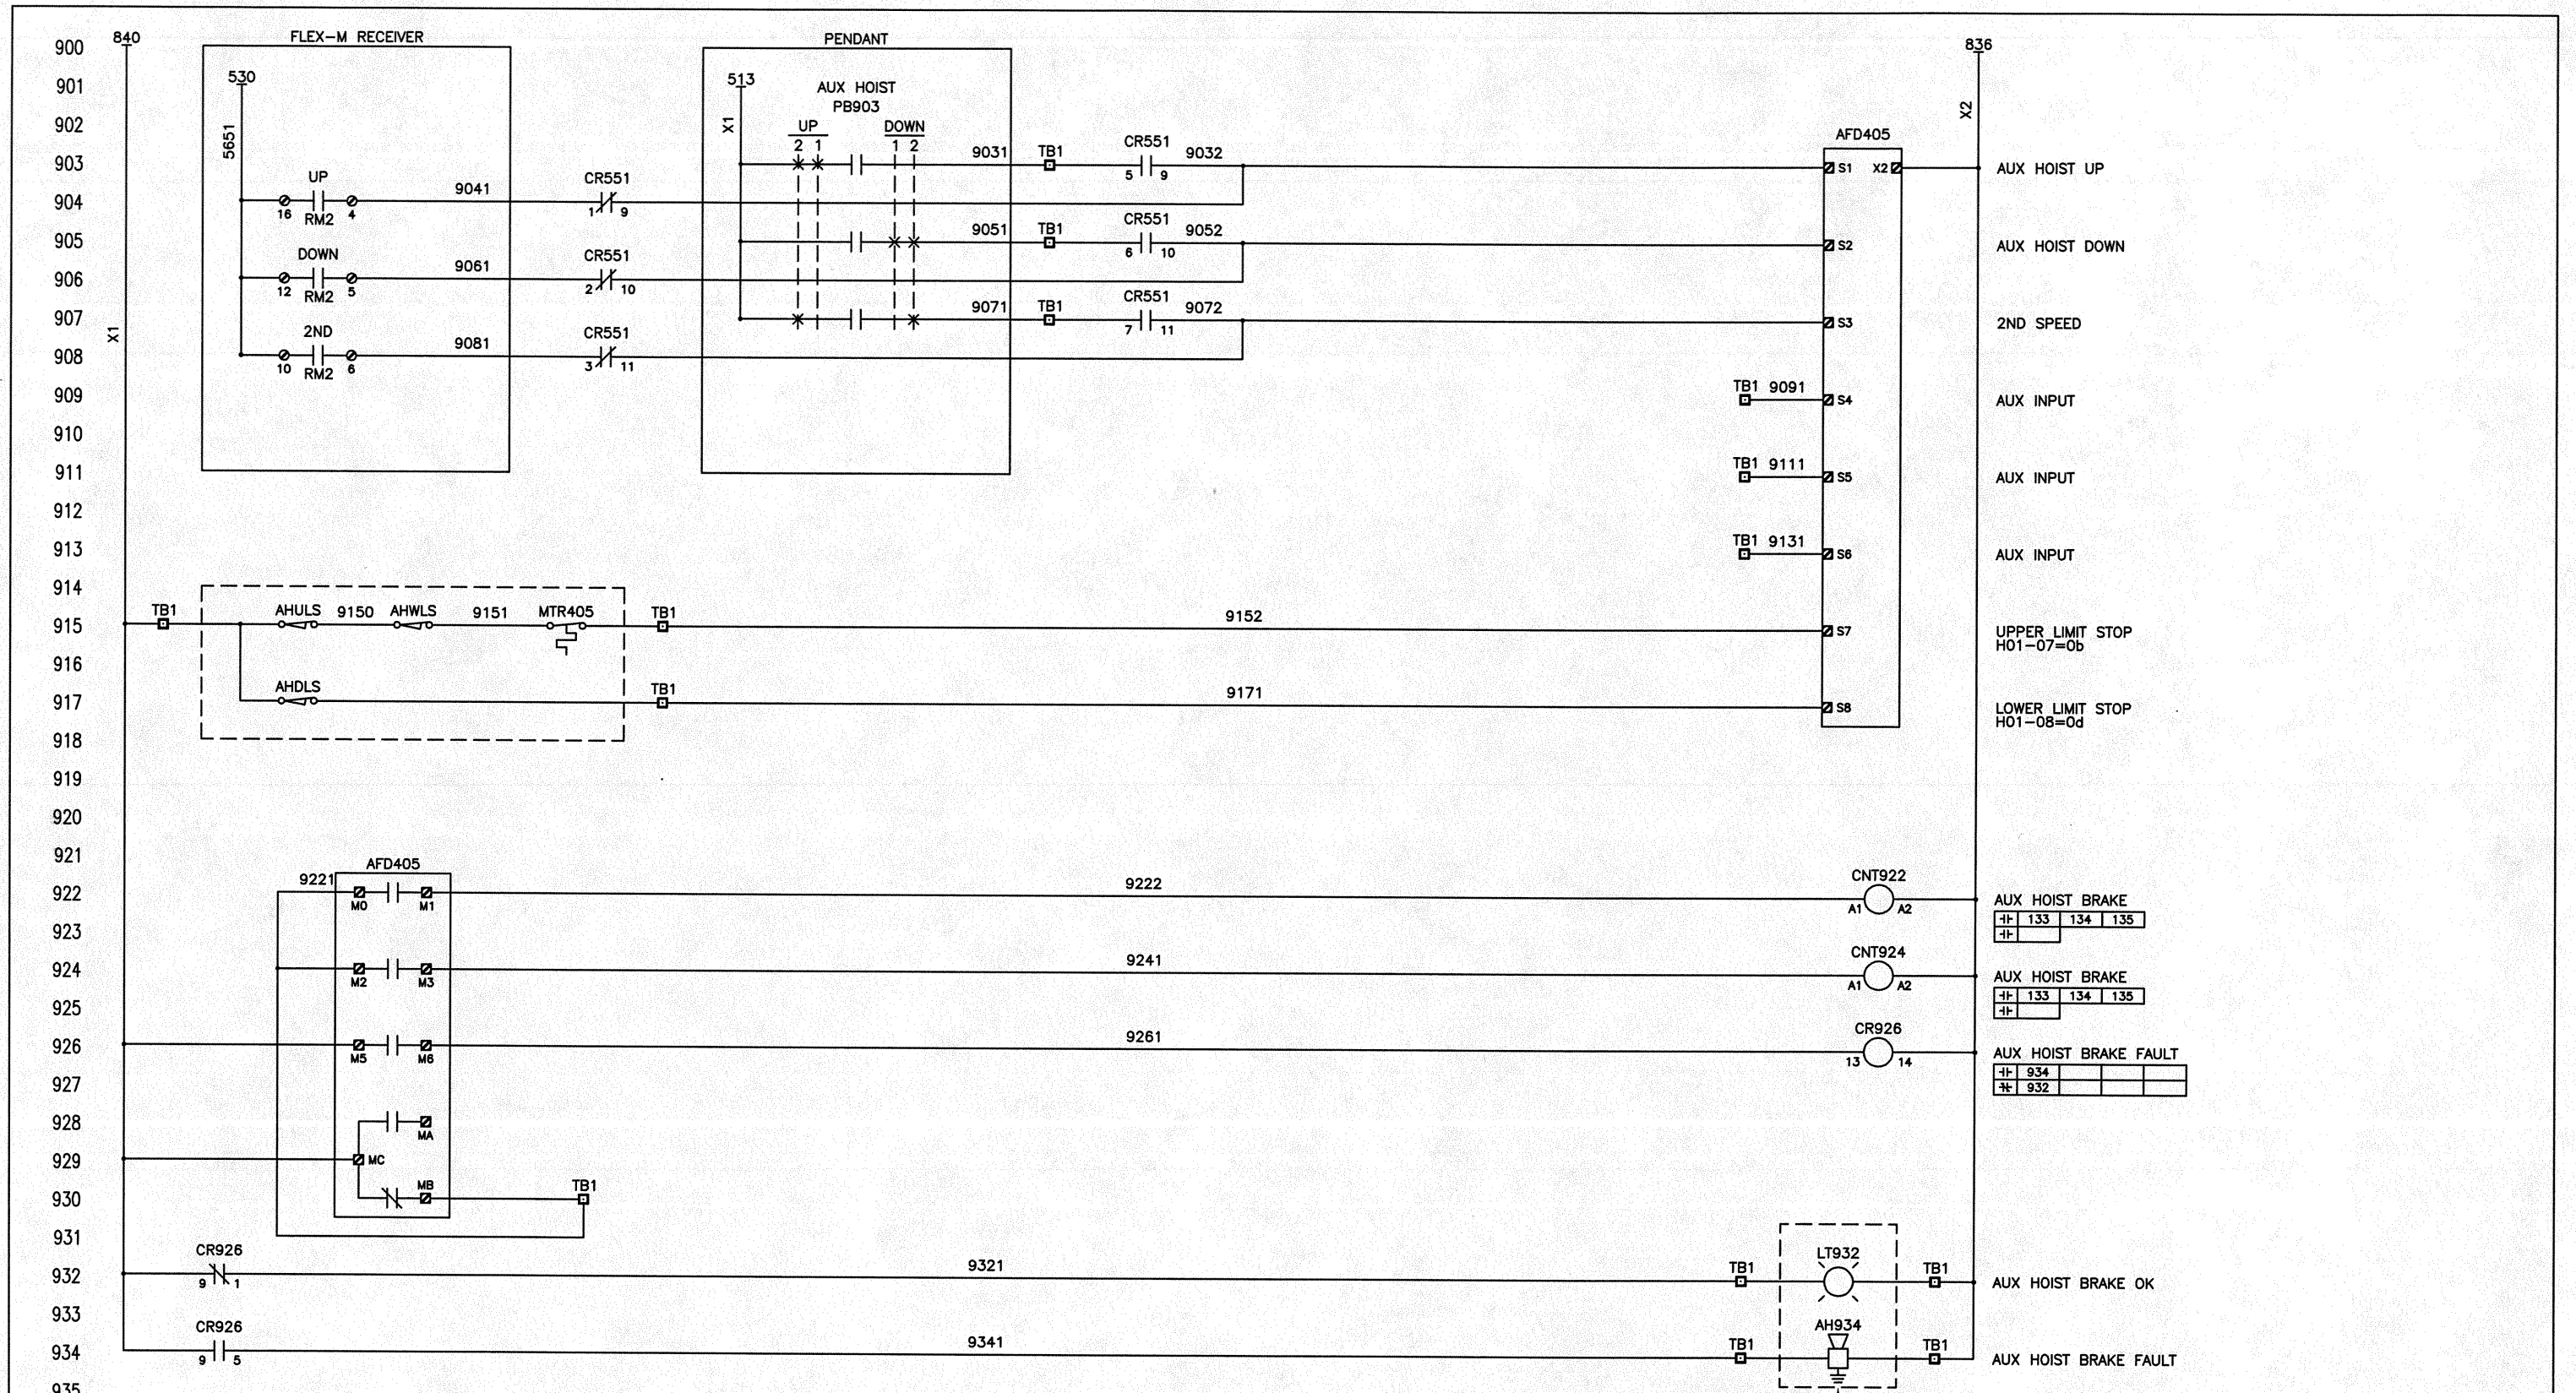



IF NO WARNING DEVICE IS INSTALLED, SET C08-12 TO 0.0 (ZERO) TO DISABLE BE6 DETECTION. SEE PAGE 5-37 OF VG+S4 INSTRUCTION MANUAL FOR FURTHER DETAILS.

CRANE 102

				262-783-3500 800-288-8178 www.magnetekmh.com			MAGNETEK MATERIAL HANDLING				
B	AS BUILT PER ECO-42237	06/16/15	ASP	AVH							
A	APPROVED PER ECO-42058	04/27/15	ASP	MRH	ACE WORLD COMPANIES				PART NUMBER 141-20869		
REV	DESCRIPTION	DATE	REV BY	APPROVED							
COPYRIGHT — MAGNETEK MATERIAL HANDLING											
THIS DRAWING AND THE DATA SHOWN THEREON IS PROPRIETARY AND CONFIDENTIAL AND THE SOLE PROPERTY OF MAGNETEK. DO NOT USE OR REPRODUCE FOR ANY PURPOSE WITHOUT THE WRITTEN CONSENT OF MAGNETEK.						DRAWN BY: ASP		DATE: 04/09/15		DESCRIPTION: CONTROL SCHEMATIC	
						CHECKED: AVH		APPROVED: SSP		DRAWING # 626388-00	
										PAGE 9 OF 10	

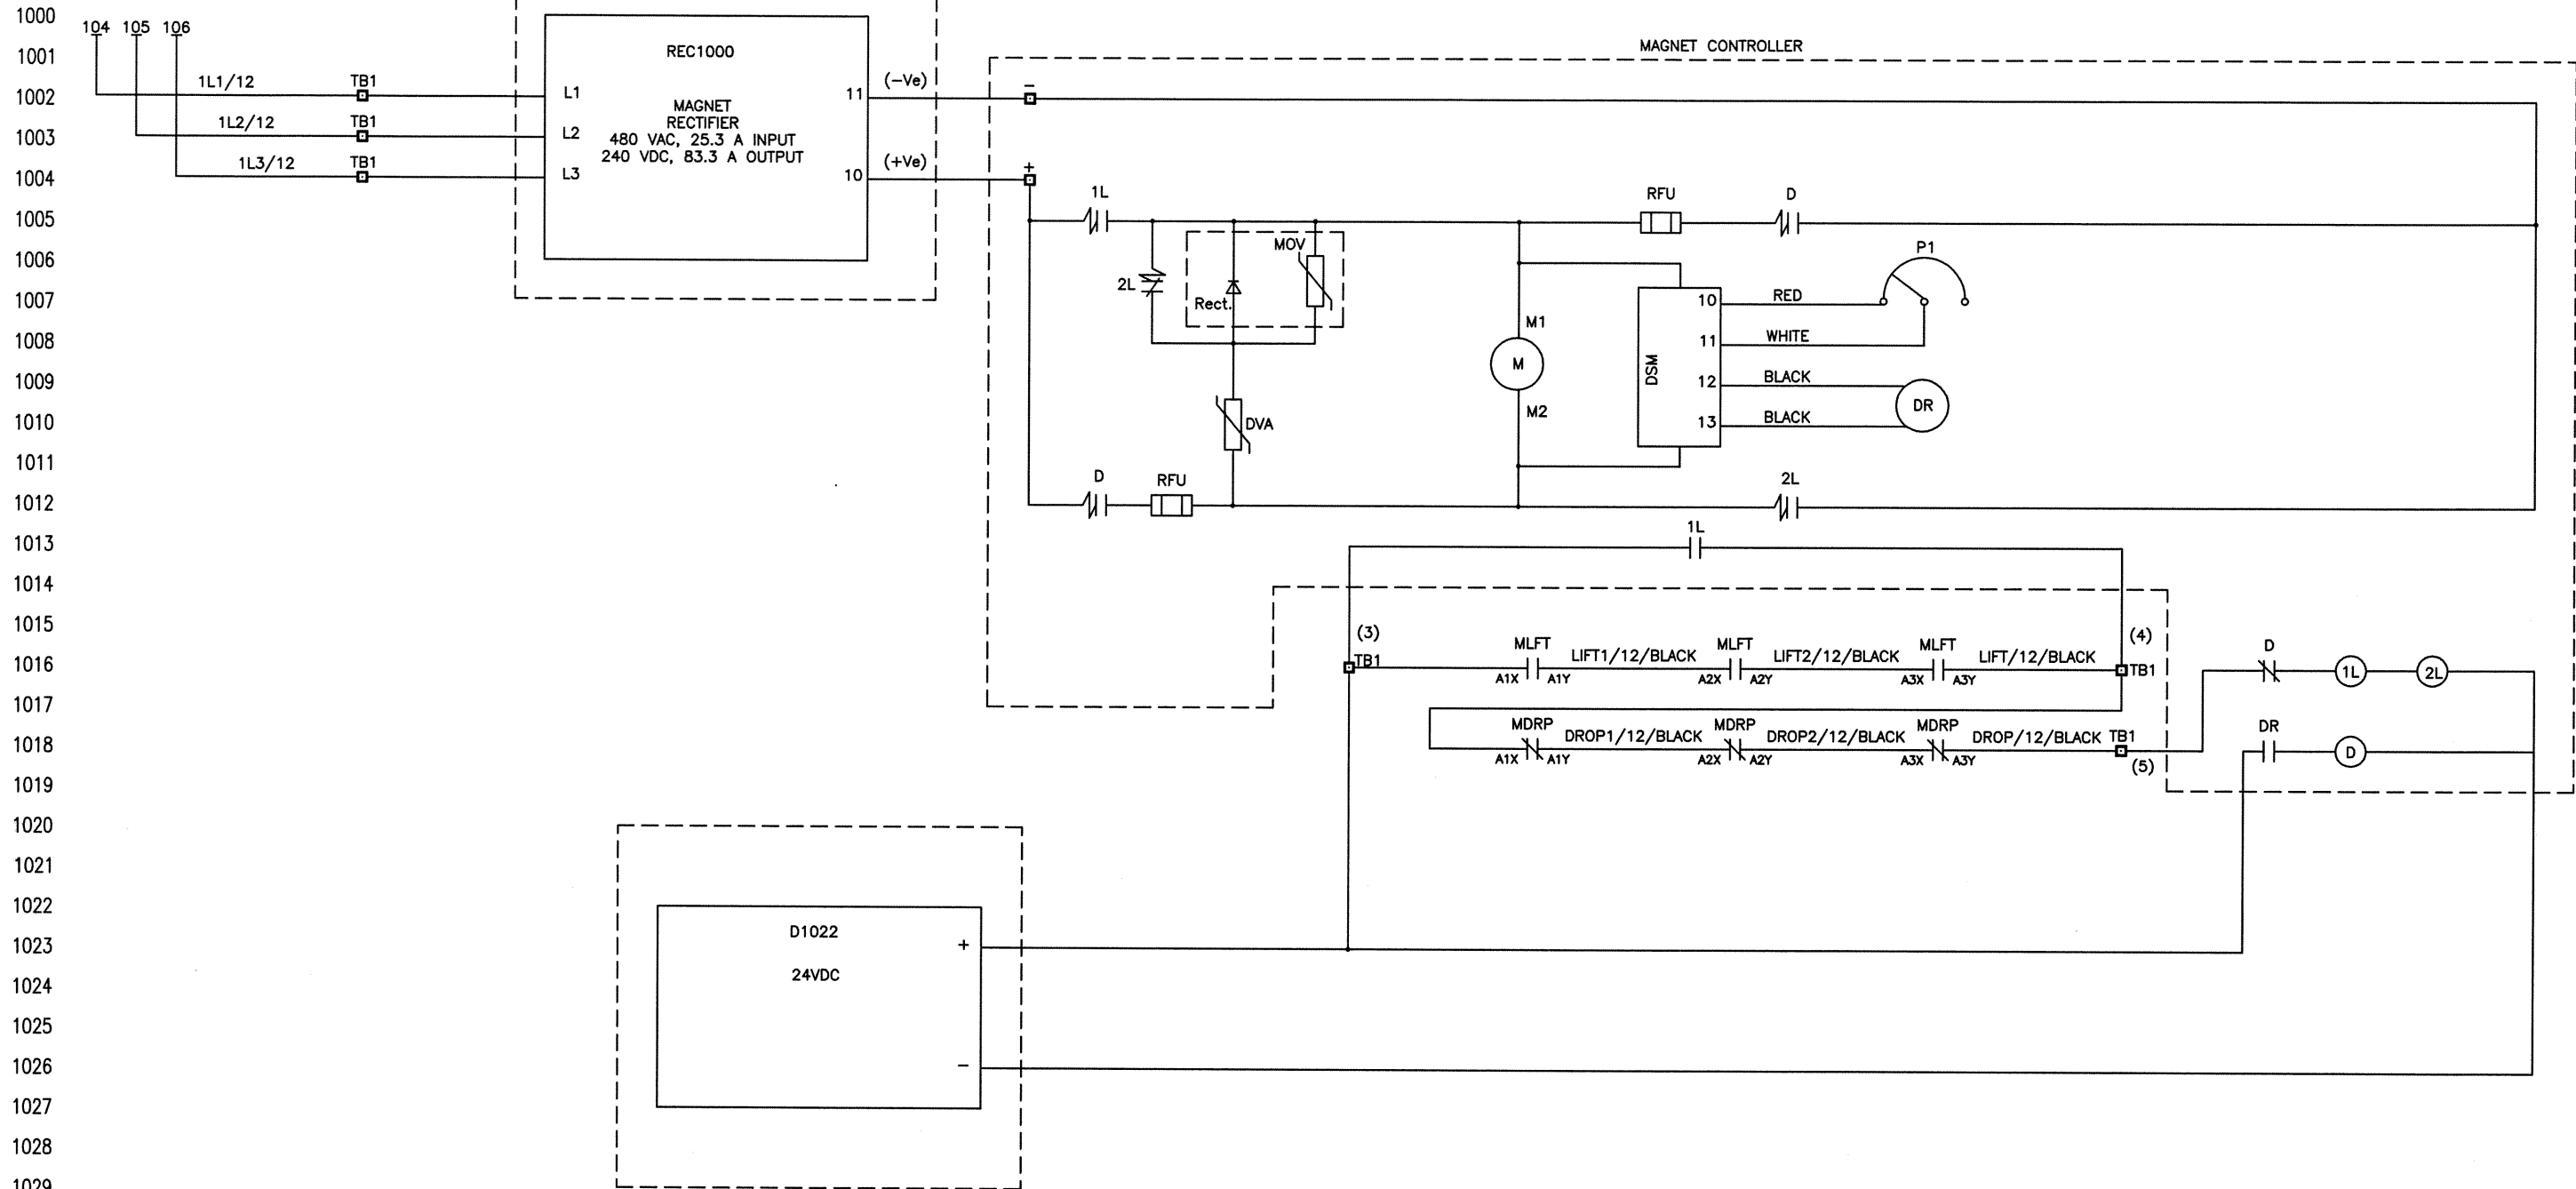


					262-783-3500 800-288-8178 www.magnetekmh.com		 MAGNETEK MATERIAL HANDLING	
B	AS BUILT PER ECO-42237	06/16/15	ASP	AVH				
A	APPROVED PER ECO-42058	04/27/15	ASP	MRH				
REV	DESCRIPTION	DATE	REV BY	APPROVED	ACE WORLD COMPANIES			PART NUMBER 141-20869
COPYRIGHT - MAGNETEK MATERIAL HANDLING								
THIS DRAWING AND THE DATA SHOWN THEREON IS PROPRIETARY AND CONFIDENTIAL AND THE SOLE PROPERTY OF MAGNETEK. DO NOT USE OR REPRODUCE FOR ANY PURPOSE WITHOUT THE WRITTEN CONSENT OF MAGNETEK					DRAWN BY: ASP	DATE: 04/09/15	DESCRIPTION: MAGNET CONTROL SCHEMATIC	
					CHECKED: AVH	APPROVED: SSP	DRAWING # 626388-00	PAGE 10 OF 10

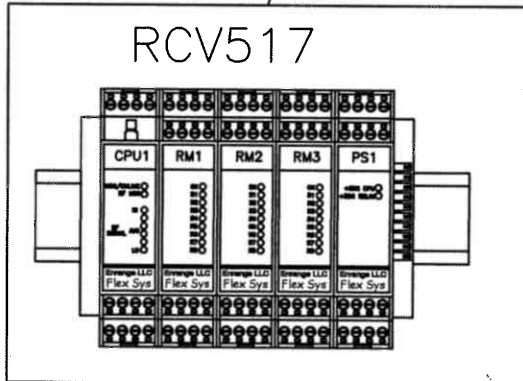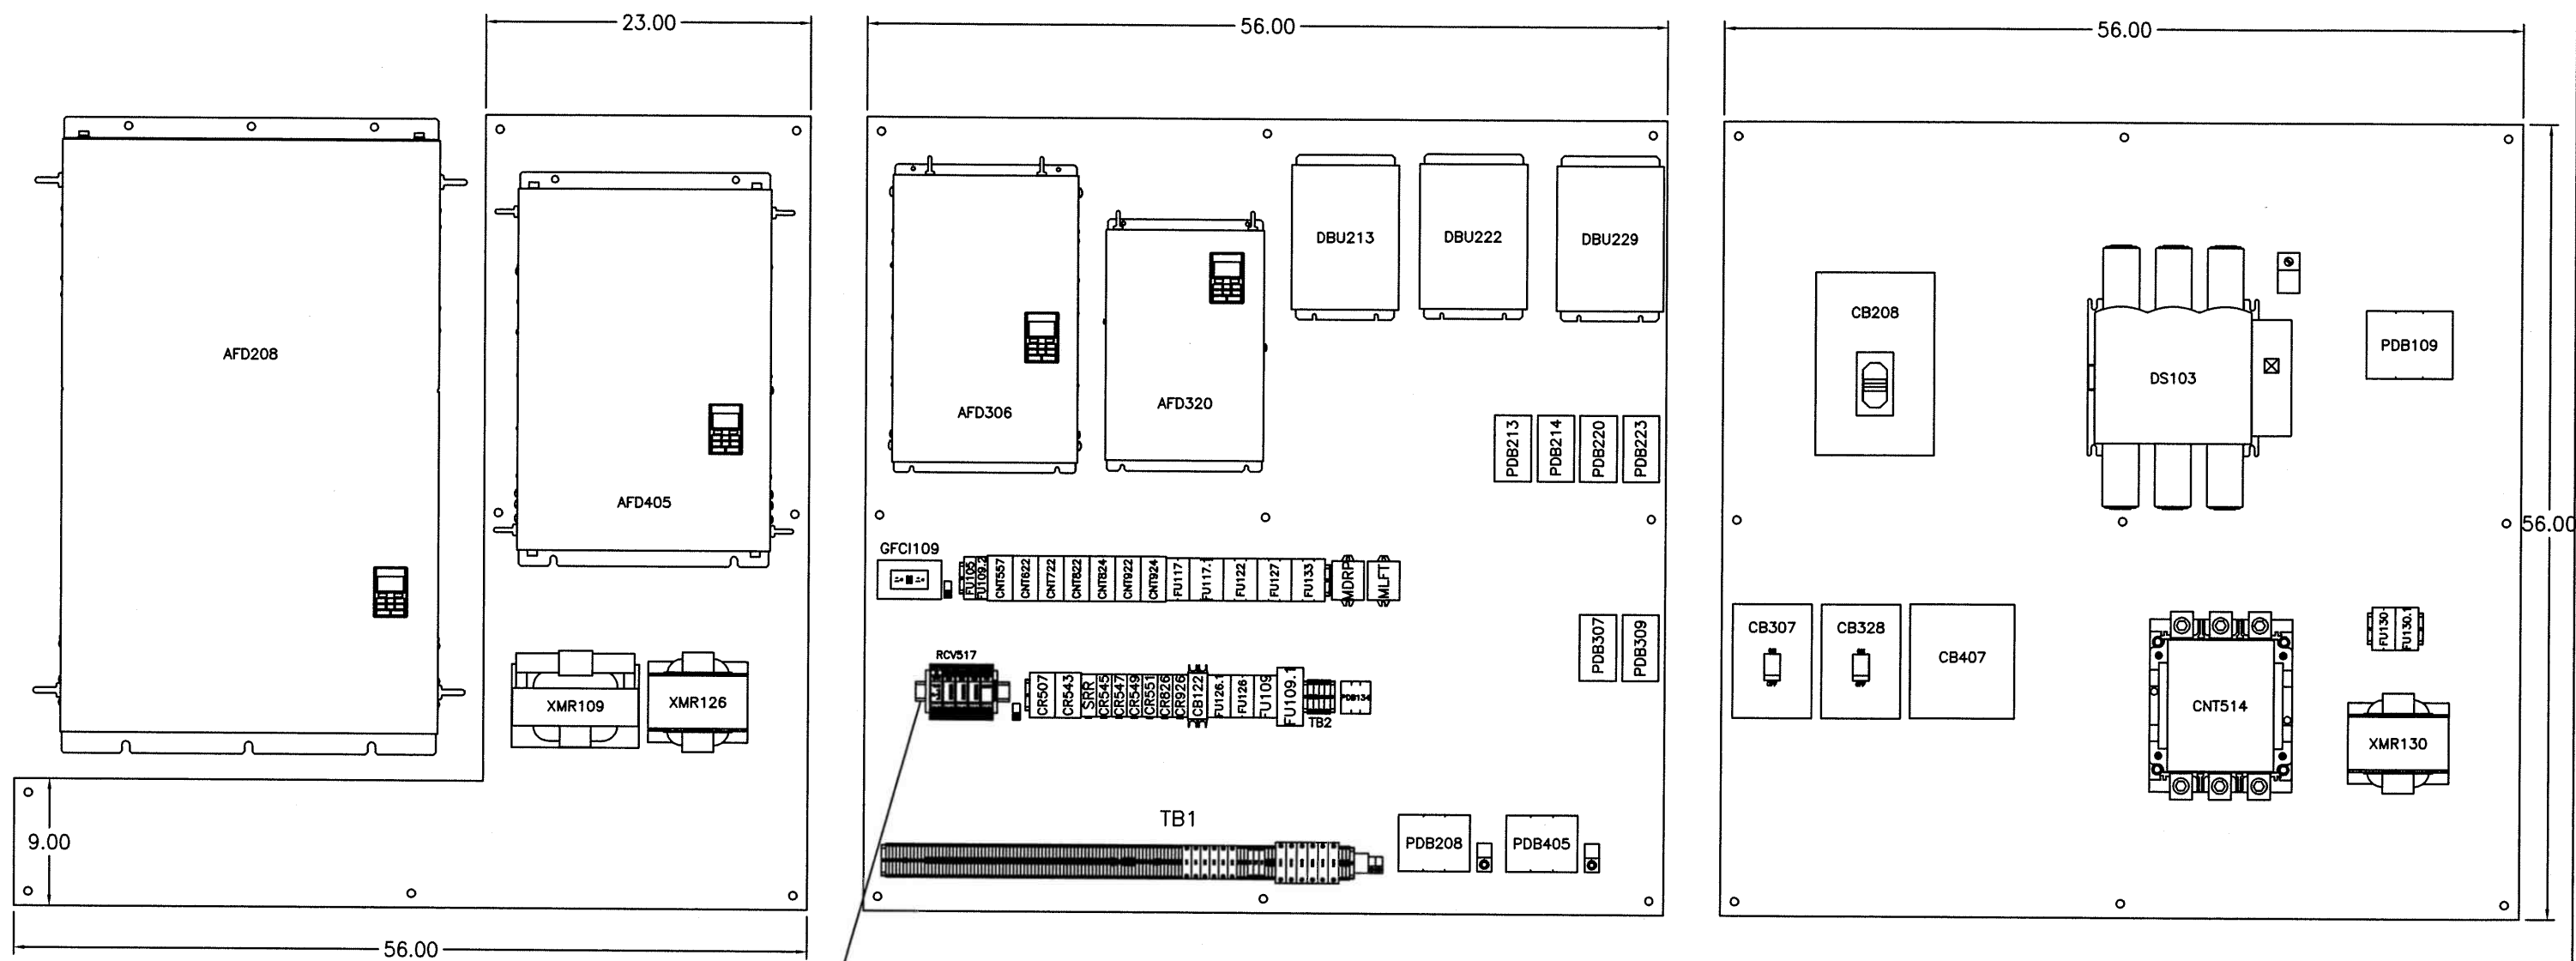

CRANE 102

				262-783-3500 800-268-8178 www.magnetekmh.com			MAGNETEK MATERIAL HANDLING	
B	AS BUILT PER ECO-42237	08/16/15	ASP	AVH				
A	APPROVED PER ECO-42058	04/27/15	ASP	MRH				
REV	DESCRIPTION	DATE	REV BY	APPROVED	ACE WORLD COMPANIES			PART NUMBER 141-20869
COPYRIGHT - MAGNETEK MATERIAL HANDLING					DRAWN BY: ASP	DATE: 04/09/15	DESCRIPTION: PANEL LAYOUT	
THIS DRAWING AND THE DATA SHOWN THEREON IS PROPRIETARY AND CONFIDENTIAL AND THE SOLE PROPERTY OF MAGNETEK. DO NOT USE OR REPRODUCE FOR ANY PURPOSE WITHOUT THE WRITTEN CONSENT OF MAGNETEK					CHECKED: AVH	APPROVED: SSP	DRAWING # 626388-01	PAGE 1 OF 4

PART NUMBER
141-20869

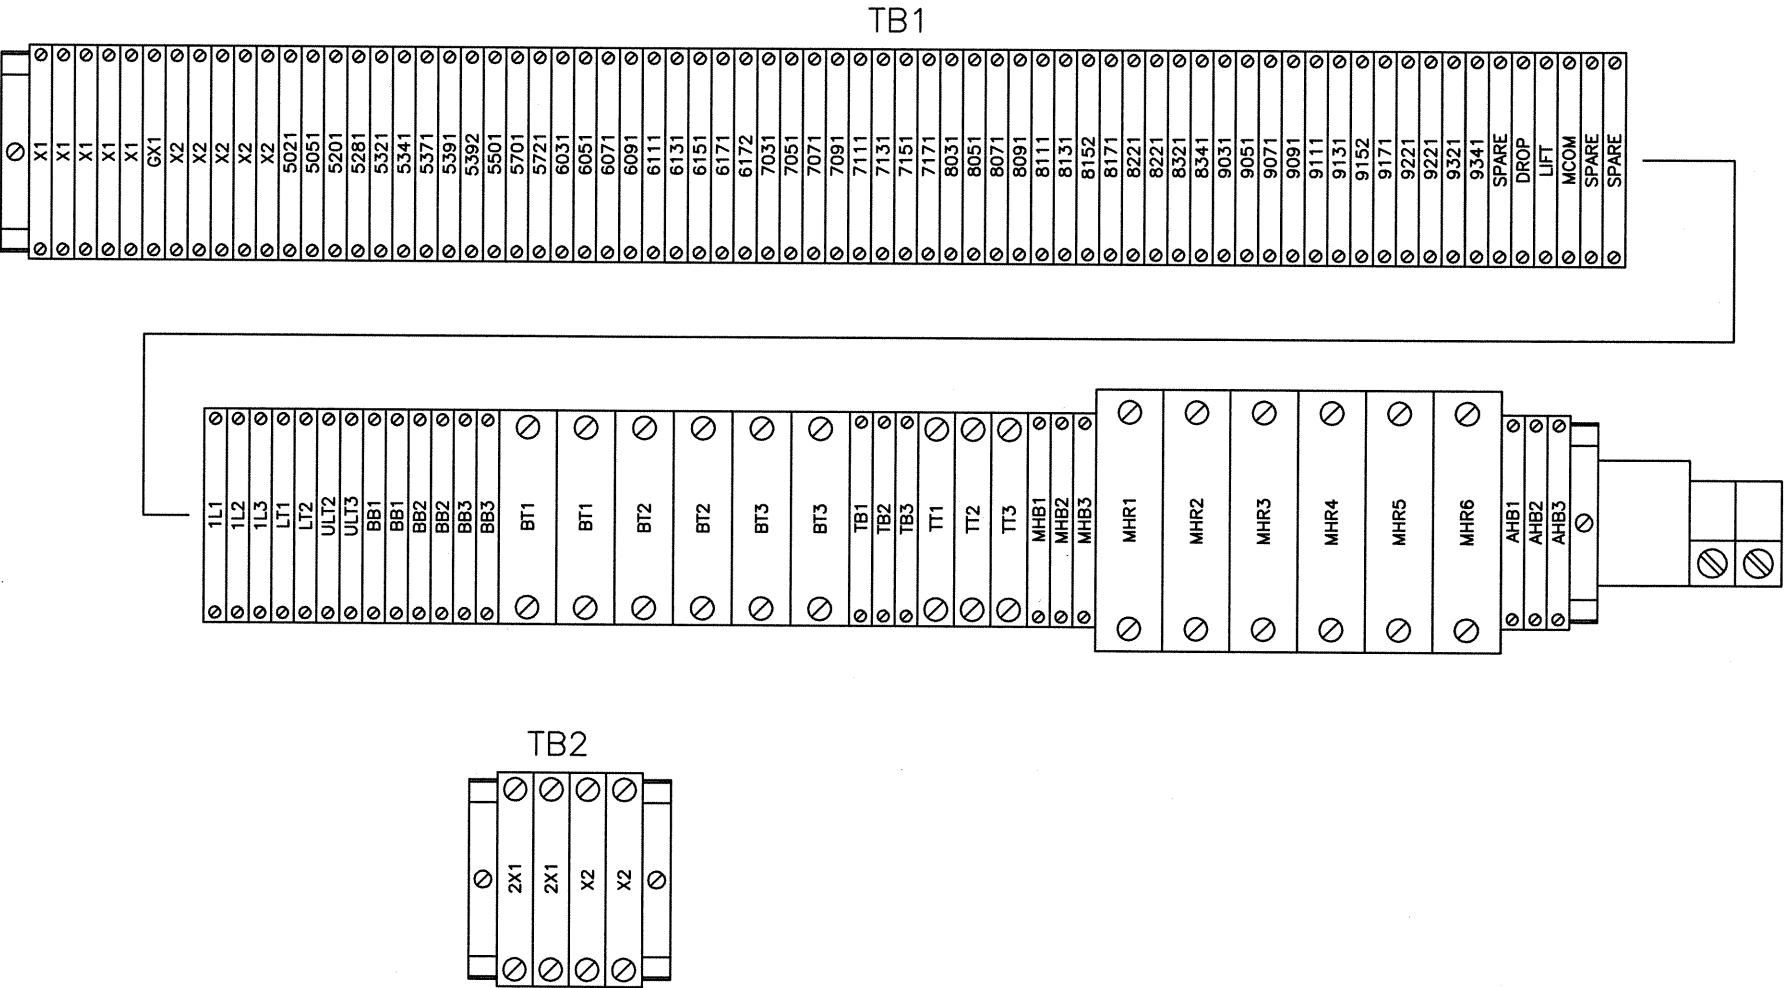

CRANE 102

					262-783-3500 800-288-8178 www.magnetekmh.com		MAGNETEK MATERIAL HANDLING		
B	AS BUILT PER ECO-42237	06/16/15	ASP	AVH					
A	APPROVED PER ECO-42058	04/27/15	ASP	MRH					
REV	DESCRIPTION	DATE	REV BY	APPROVED	ACE WORLD COMPANIES			PART NUMBER 141-20869	
COPYRIGHT - MAGNETEK MATERIAL HANDLING					DRAWN BY: ASP	DATE: 04/09/15	DESCRIPTION: TERMINAL STRIP		
THIS DRAWING AND THE DATA SHOWN THEREON IS PROPRIETARY AND CONFIDENTIAL AND THE SOLE PROPERTY OF MAGNETEK. DO NOT USE OR REPRODUCE FOR ANY PURPOSE WITHOUT THE WRITTEN CONSENT OF MAGNETEK					CHECKED: AVH	APPROVED: SSP	DRAWING # 626388-01	PAGE 2 OF 4	

DEVICE ID	QTY.	PART NUMBER	DESCRIPTION	MANUFACTURER	CATALOG NUMBER
AC126	1	144-15157	CUTOUT FOR DTS-32x5 AIR CONDITIONER		
AC126	1	144-15476	AIR CONDITIONER, 10000 BTU, HIGH TEMP 140F, 230V	PFFANNENBERG	DTS3265HT
AC130	1	144-15157	CUTOUT FOR DTS-32x5 AIR CONDITIONER		
AC130	1	144-15476	AIR CONDITIONER, 10000 BTU, HIGH TEMP 140F, 230V	PFFANNENBERG	DTS3265HT
AFD208	1	144-23172	ADJUSTABLE FREQUENCY DRIVE, 605A, 460VAC	MAGNETEK	4605-VG+S4
AFD306	1	144-23100	ADJUSTABLE FREQUENCY DRIVE, 112A, 460VAC	MAGNETEK	4112-G+S4
AFD320	1	144-23097	ADJUSTABLE FREQUENCY DRIVE, 60A, 460VAC	MAGNETEK	4060-G+S4
AFD405	1	144-23166	ADJUSTABLE FREQUENCY DRIVE, 180A, 460VAC	MAGNETEK	4180-VG+S4
CB122	1	144-18413	CIRCUIT BREAKER, 2 POLE, 20A, 480Y/277VAC	ALLEN BRADLEY	1489-M2D200
CB208	1	144-15270	CIRCUIT BREAKER, 3 POLE, 800A, 600V	SQUARE-D	MGL36800
CB307	1	144-18345	CIRCUIT BREAKER, 4-POLE, 250A, 600VAC/600VDC	ABB	T4H250TW-4
CB307	2	144-18347	LUG KIT, SET OF 4	ABB	KT4250-4
CB328	2	144-18347	LUG KIT, SET OF 4	ABB	KT4250-4
CB328	1	144-19222	CIRCUIT BREAKER, 4-POLE, 150A, 600VAC/VDC	ABB	T4H150TW-4
CB407	2	144-18347	LUG KIT, SET OF 4	ABB	KT4250-4
CB407	1	144-19214	CIRCUIT BREAKER, 4-POLE, 400A, 600VAC/VDC	ABB	T5H400TW-4
CNT514	1	009-9126	SURGE SUPPRESSOR, MOV	LITTELFUSE	V130LA20BP
CNT514	1	144-11648	CONTACTOR IEC, 860A, 3-POLE, AC/EI COIL, 1NO-1NC AUX.	ALLEN BRADLEY	100-D860ED11
CNT514	6	144-19295	BUS BAR 2 HOLE	MAGNETEK	
CNT557	1	006-2503	CONTACTOR, IEC, 3-POLE, 23A, 120VAC COIL	ALLEN BRADLEY	100-C23D10
CNT557	1	009-9126	SURGE SUPPRESSOR, MOV	LITTELFUSE	V130LA20BP
CNT622	1	006-2500	CONTACTOR, IEC, 3-POLE, 9A, 120VAC COIL	ALLEN BRADLEY	100-C09D10
CNT622	1	009-9126	SURGE SUPPRESSOR, MOV	LITTELFUSE	V130LA20BP
CNT722	1	006-2500	CONTACTOR, IEC, 3-POLE, 9A, 120VAC COIL	ALLEN BRADLEY	100-C09D10
CNT722	1	009-9126	SURGE SUPPRESSOR, MOV	LITTELFUSE	V130LA20BP
CNT822	1	006-2500	CONTACTOR, IEC, 3-POLE, 9A, 120VAC COIL	ALLEN BRADLEY	100-C09D10
CNT822	1	009-9126	SURGE SUPPRESSOR, MOV	LITTELFUSE	V130LA20BP
CNT824	1	006-2500	CONTACTOR, IEC, 3-POLE, 9A, 120VAC COIL	ALLEN BRADLEY	100-C09D10
CNT824	1	009-9126	SURGE SUPPRESSOR, MOV	LITTELFUSE	V130LA20BP
CNT922	1	006-2500	CONTACTOR, IEC, 3-POLE, 9A, 120VAC COIL	ALLEN BRADLEY	100-C09D10
CNT922	1	009-9126	SURGE SUPPRESSOR, MOV	LITTELFUSE	V130LA20BP
CNT924	1	006-2500	CONTACTOR, IEC, 3-POLE, 9A, 120VAC COIL	ALLEN BRADLEY	100-C09D10
CNT924	1	009-9126	SURGE SUPPRESSOR, MOV	LITTELFUSE	V130LA20BP
CR507	1	006-7530	CONTROL RELAY, 2NO-2NC, 120VAC COIL	ALLEN BRADLEY	700-CF220D
CR507	1	009-9126	SURGE SUPPRESSOR, MOV	LITTELFUSE	V130LA20BP
CR543	1	006-7530	CONTROL RELAY, 2NO-2NC, 120VAC COIL	ALLEN BRADLEY	700-CF220D
CR543	1	009-9126	SURGE SUPPRESSOR, MOV	LITTELFUSE	V130LA20BP
CR545	2	060-5025	PLUG-IN RELAY ASSEMBLY, 4PDT, 120VAC COIL, IEC	FINDER	
CR547	2	060-5025	PLUG-IN RELAY ASSEMBLY, 4PDT, 120VAC COIL, IEC	FINDER	
CR549	1	060-5025	PLUG-IN RELAY ASSEMBLY, 4PDT, 120VAC COIL, IEC	FINDER	
CR551	1	060-5025	PLUG-IN RELAY ASSEMBLY, 4PDT, 120VAC COIL, IEC	FINDER	
CR826	1	060-5025	PLUG-IN RELAY ASSEMBLY, 4PDT, 120VAC COIL, IEC	FINDER	
CR926	1	060-5025	PLUG-IN RELAY ASSEMBLY, 4PDT, 120VAC COIL, IEC	FINDER	
DBU213	1	146-10141	DYNAMIC BRAKING UNIT, 220kW, 460V	MAGNETEK	CDBR-4220D
DBU222	1	146-10141	DYNAMIC BRAKING UNIT, 220kW, 460V	MAGNETEK	CDBR-4220D
DBU229	1	146-10141	DYNAMIC BRAKING UNIT, 220kW, 460V	MAGNETEK	CDBR-4220D
DS103	3	006-4525	FUSE 800 AMP TIME DELAY, CLASS L	BUSSMANN	KRP-C-800SP
DS103	1	009-1050	GROUND LUG	ILSCO	TA-500
DS103	1	144-17560	DISCONNECT SWITCH, FUSED, 800A, 600V	ALLEN BRADLEY	194R-L800-1753
DS103	1	144-17563	OPERATING HANDLE, NEMA 3R,12,4,4X	ALLEN BRADLEY	194R-HM4-L
DS103	1	144-17564	OPERATING SHAFT, EXTENDED LENGTH	ALLEN BRADLEY	194R-R12
FU105	1	006-4051	FUSE, TIME-DELAY, 10A, 500V	FERRAZ SHAWMUT	ATQ10
FU105	1	006-4299	DIN RAIL ADAPTER FOR 30/60A FUSE BLOCK	BUSSMANN	DRA-1
FU105	1	903-9023	FUSE BLOCK, TYPE M, 1-POLE, 30A, 600V	BUSSMANN	BM6031B
FU109	1	006-4299	DIN RAIL ADAPTER FOR 30/60A FUSE BLOCK	BUSSMANN	DRA-1
FU109	1	006-4302	FUSE BLOCK, CLASS CC, 2-POLE, 30A, 600V	BUSSMANN	BC6032P
FU109	2	144-10023	FUSE, CLASS CC, 10A, 600V	FERRAZ SHAWMUT	ATQR10
FU109.1	1	006-4299	DIN RAIL ADAPTER FOR 30/60A FUSE BLOCK	BUSSMANN	DRA-1
FU109.1	1	006-4435	FUSE, CLASS J, 35A, 600V	FERRAZ/BUSSMANN	AJT35/LPJ35SP
FU109.1	1	144-10319	FUSE BLOCK, CLASS J, 1-POLE, 60A, 600V	BUSSMANN	J60060-1C
FU109.2	1	006-4054	FUSE, TIME-DELAY, 15A, 500V	FERRAZ SHAWMUT	ATQ15
FU109.2	1	006-4299	DIN RAIL ADAPTER FOR 30/60A FUSE BLOCK	BUSSMANN	DRA-1
FU109.2	1	903-9023	FUSE BLOCK, TYPE M, 1-POLE, 30A, 600V	BUSSMANN	BM6031B
FU117	2	006-4070	FUSE, CLASS CC, 5A, 600V	FERRAZ/BUSSMANN	ATDR5/LPCC5
FU117	1	006-4299	DIN RAIL ADAPTER FOR 30/60A FUSE BLOCK	BUSSMANN	DRA-1
FU117	1	006-4302	FUSE BLOCK, CLASS CC, 2-POLE, 30A, 600V	BUSSMANN	BC6032P
FU117.1	3	006-4068	FUSE, CLASS CC, 3A, 600V	FERRAZ/BUSSMANN	ATDR3/LPCC3
FU117.1	2	006-4299	DIN RAIL ADAPTER FOR 30/60A FUSE BLOCK	BUSSMANN	DRA-1
FU117.1	1	006-4303	FUSE BLOCK, CLASS CC, 3-POLE, 30A, 600V	BUSSMANN	BC6033P
FU122	3	006-4068	FUSE, CLASS CC, 3A, 600V	FERRAZ/BUSSMANN	ATDR3/LPCC3
FU122	2	006-4299	DIN RAIL ADAPTER FOR 30/60A FUSE BLOCK	BUSSMANN	DRA-1

DEVICE ID	QTY.	PART NUMBER	DESCRIPTION	MANUFACTURER	CATALOG NUMBER
FU122	1	006-4303	FUSE BLOCK, CLASS CC, 3-POLE, 30A, 600V	BUSSMANN	BC6033P
FU126	1	006-4299	DIN RAIL ADAPTER FOR 30/60A FUSE BLOCK	BUSSMANN	DRA-1
FU126	2	144-10023	FUSE, CLASS CC, 10A, 600V	FERRAZ SHAWMUT	ATQR10
FU126	1	144-18044	FUSE BLOCK CLASS CC, 2-POLE, 30A, 600V	BUSSMANN	BC6032PQ
FU126.1	2	006-4054	FUSE, TIME-DELAY, 15A, 500V	FERRAZ SHAWMUT	ATQ15
FU126.1	1	006-4299	DIN RAIL ADAPTER FOR 30/60A FUSE BLOCK	BUSSMANN	DRA-1
FU126.1	1	144-10672	FUSE BLOCK, TYPE M, 2-POLE, 30A, 600V	BUSSMANN	BM6032B
FU127	3	006-4068	FUSE, CLASS CC, 3A, 600V	FERRAZ/BUSSMANN	ATDR3/LPCC3
FU127	2	006-4299	DIN RAIL ADAPTER FOR 30/60A FUSE BLOCK	BUSSMANN	DRA-1
FU127	1	006-4303	FUSE BLOCK, CLASS CC, 3-POLE, 30A, 600V	BUSSMANN	BC6033P
FU130	1	006-4299	DIN RAIL ADAPTER FOR 30/60A FUSE BLOCK	BUSSMANN	DRA-1
FU130	2	144-10023	FUSE, CLASS CC, 10A, 600V	FERRAZ SHAWMUT	ATQR10
FU130	1	144-18044	FUSE BLOCK CLASS CC, 2-POLE, 30A, 600V	BUSSMANN	BC6032PQ
FU130.1	2	006-4054	FUSE, TIME-DELAY, 15A, 500V	FERRAZ SHAWMUT	ATQ15
FU130.1	1	006-4299	DIN RAIL ADAPTER FOR 30/60A FUSE BLOCK	BUSSMANN	DRA-1
FU130.1	1	144-10672	FUSE BLOCK, TYPE M, 2-POLE, 30A, 600V	BUSSMANN	BM6032B
FU133	3	006-4068	FUSE, CLASS CC, 3A, 600V	FERRAZ/BUSSMANN	ATDR3/LPCC3
FU133	2	006-4299	DIN RAIL ADAPTER FOR 30/60A FUSE BLOCK	BUSSMANN	DRA-1
FU133	1	006-4303	FUSE BLOCK, CLASS CC, 3-POLE, 30A, 600V	BUSSMANN	BC6033P
GFCI109	1	009-8916	GFCI, DUPLEX RECEPTACLE, 15A, 125VAC	EAGLE ELECTRIC	GF15W
GFCI109	1	009-8998	SWITCH BOX, SINGLE-GANG, 2-1/2" DEEP	RACO	500
MDRP	1	901-9027	CONTROL RELAY, 4-POLE, 120VAC COIL	ALLEN BRADLEY	700-P400A1
MLFT	1	009-9126	SURGE SUPPRESSOR, MOV	LITTELFUSE	V130LA20BP
MLFT	1	901-9027	CONTROL RELAY, 4-POLE, 120VAC COIL	ALLEN BRADLEY	700-P400A1
N/A	1	144-12244	10-POLE SCREW TYPE JUMPER FOR 1492-J35 TERMINAL BLOCK	ALLEN BRADLEY	1492-CJJ16-10
N/A	1	144-19251	NEMA 12 ENCLOSURE. 62H X 180W X 18D, 2 CUTOUTS, DRIVE	ENCL INC/IEC	
N/A	1	144-19252	CUSTOM PANEL, 56H X 56W WITH CUTOUT	ENCL INC/IEC	
N/A	2	9-05656	PANEL, 56 X 56	ENCLSR INC./IEC	
PB505	1	127-23257	SBP2 TANDEM PENDANT	MAGNETEK	
PDB109	1	900-9117	POWER DISTRIBUTION BLOCK, 3-POLE, 335A, 600V	ALLEN BRADLEY	1492-PD3183
PDB134	1	144-15220	POWER DISTRIBUTION BLOCK, 3-POLE, 175A, 600V	ALLEN BRADLEY	1492-PDM3141
PDB208	1	001-1844	GROUND LUG	PENN-UNION	LA-250
PDB208	1	900-9120	POWER DISTRIBUTION BLOCK, 3-POLE, 310A, 600V	ALLEN BRADLEY	1492-PD3113
PDB213	1	144-19147	1-POLE DISTRIBUTION BLOCK, 760A, CERTIFIED FOR 1000VDC	COOPER BUSSMANN	PDBF5504
PDB214	1	144-19147	1-POLE DISTRIBUTION BLOCK, 760A, CERTIFIED FOR 1000VDC	COOPER BUSSMANN	PDBF5504
PDB220	1	144-19147	1-POLE DISTRIBUTION BLOCK, 760A, CERTIFIED FOR 1000VDC	COOPER BUSSMANN	PDBF5504
PDB223	1	144-19147	1-POLE DISTRIBUTION BLOCK, 760A, CERTIFIED FOR 1000VDC	COOPER BUSSMANN	PDBF5504
PDB307	1	144-19147	1-POLE DISTRIBUTION BLOCK, 760A, CERTIFIED FOR 1000VDC	COOPER BUSSMANN	PDBF5504
PDB309	1	144-19147	1-POLE DISTRIBUTION BLOCK, 760A, CERTIFIED FOR 1000VDC	COOPER BUSSMANN	PDBF5504
PDB405	1	001-1844	GROUND LUG	PENN-UNION	LA-250
PDB405	1	900-9120	POWER DISTRIBUTION BLOCK, 3-POLE, 310A, 600V	ALLEN BRADLEY	1492-PD3113
RCV517	1	175-12526-2002	FLEX-M RADIO RECEIVER	MAGNETEK	
SRR	2	060-5025	PLUG-IN RELAY ASSEMBLY, 4PDT, 120VAC COIL, IEC	FINDER	
SS537	1	144-16284	LEGEND PLATE, 30MM, STANDARD, SILVER/BLK, CUSTOM TEXT	MAGNETEK	
SS537	1	906-9062	SELECTOR SWITCH, 2-POSITION, TYPE 4/4X/13	ALLEN BRADLEY	800H-HR2A
SS543	1	144-16284	LEGEND PLATE, 30MM, STANDARD, SILVER/BLK, CUSTOM TEXT	MAGNETEK	
SS543	1	906-9062	SELECTOR SWITCH, 2-POSITION, TYPE 4/4X/13	ALLEN BRADLEY	800H-HR2A
TB1	93	144-12153	TERMINAL BLOCK, 35A, 600V	ALLEN BRADLEY	1492-J4
TB1	3	144-12155	TERMINAL BLOCK, 65A, 600V	ALLEN BRADLEY	1492-J10
TB1	6	144-12157	TERMINAL BLOCK, 115A, 1000V	ALLEN BRADLEY	1492-J35
TB1	6	144-12158	TERMINAL BLOCK, 150A, 600V	ALLEN BRADLEY	1492-J50
TB2	4	144-12155	TERMINAL BLOCK, 65A, 600V	ALLEN BRADLEY	1492-J10
XMR109	1	907-9213	TRANSFORMER, 3000VA, 230/460V-115V	SQUARE D	9070T3000D1
XMR126	1	144-10181	TRANSFORMER, 2000VA, 230/460V-115/230V	SQUARE D	9070T2000D31
XMR130	1	144-10181	TRANSFORMER, 2000VA, 230/460V-115/230V	SQUARE D	9070T2000D31

CRANE 102

				282-783-3500 800-288-8178 www.magnetekmh.com		 MAGNETEK MATERIAL HANDLING	
B	AS BUILT PER ECO-42237	06/16/15	ASP	AVH			
A	APPROVED PER ECO-42058	04/27/15	ASP	MRH			
REV	DESCRIPTION	DATE	REV BY	APPROVED	ACE WORLD COMPANIES		PART NUMBER 141-20869
COPYRIGHT - MAGNETEK MATERIAL HANDLING THIS DRAWING AND THE DATA SHOWN THEREON IS PROPRIETARY AND CONFIDENTIAL AND THE SOLE PROPERTY OF MAGNETEK. DO NOT USE OR REPRODUCE FOR ANY PURPOSE WITHOUT THE WRITTEN CONSENT OF MAGNETEK					DRAWN BY: ASP DATE: 04/09/15 DESCRIPTION: BILL OF MATERIAL		
CHECKED: AVH APPROVED: SSP DRAWING # 626388-01					PAGE 3 OF 4		

