

INSTALLATION REQUIREMENTS

ELECTRICAL

MAIN SUPPLY LINE TO CONTROL PANEL TO MACHINE:
17 KVA @ 460 V, 3 PHASE, 60 Hz.
(ADD 3 KVA FOR 2 HP DUST COLLECTOR)

VENTILATION


CABINET: (2) 5" ϕ LINES W/AIR GATES, 900 CFM.
NO VENTILATION LINES ARE REQUIRED
WITH INTEGRATED DUST COLLECTOR

COMPRESSED AIR

ANTI-STAT AND BLOW-OFF: 1/2" NPT INLET
3 CFM @ 80-100 PSI.

DUST COLLECTOR: 1 1/2" NPT INLET, 1 CFM @ 30-50 PSI.

NOTE: SOME ITEMS HAVE BEEN REMOVED FOR CLARITY.

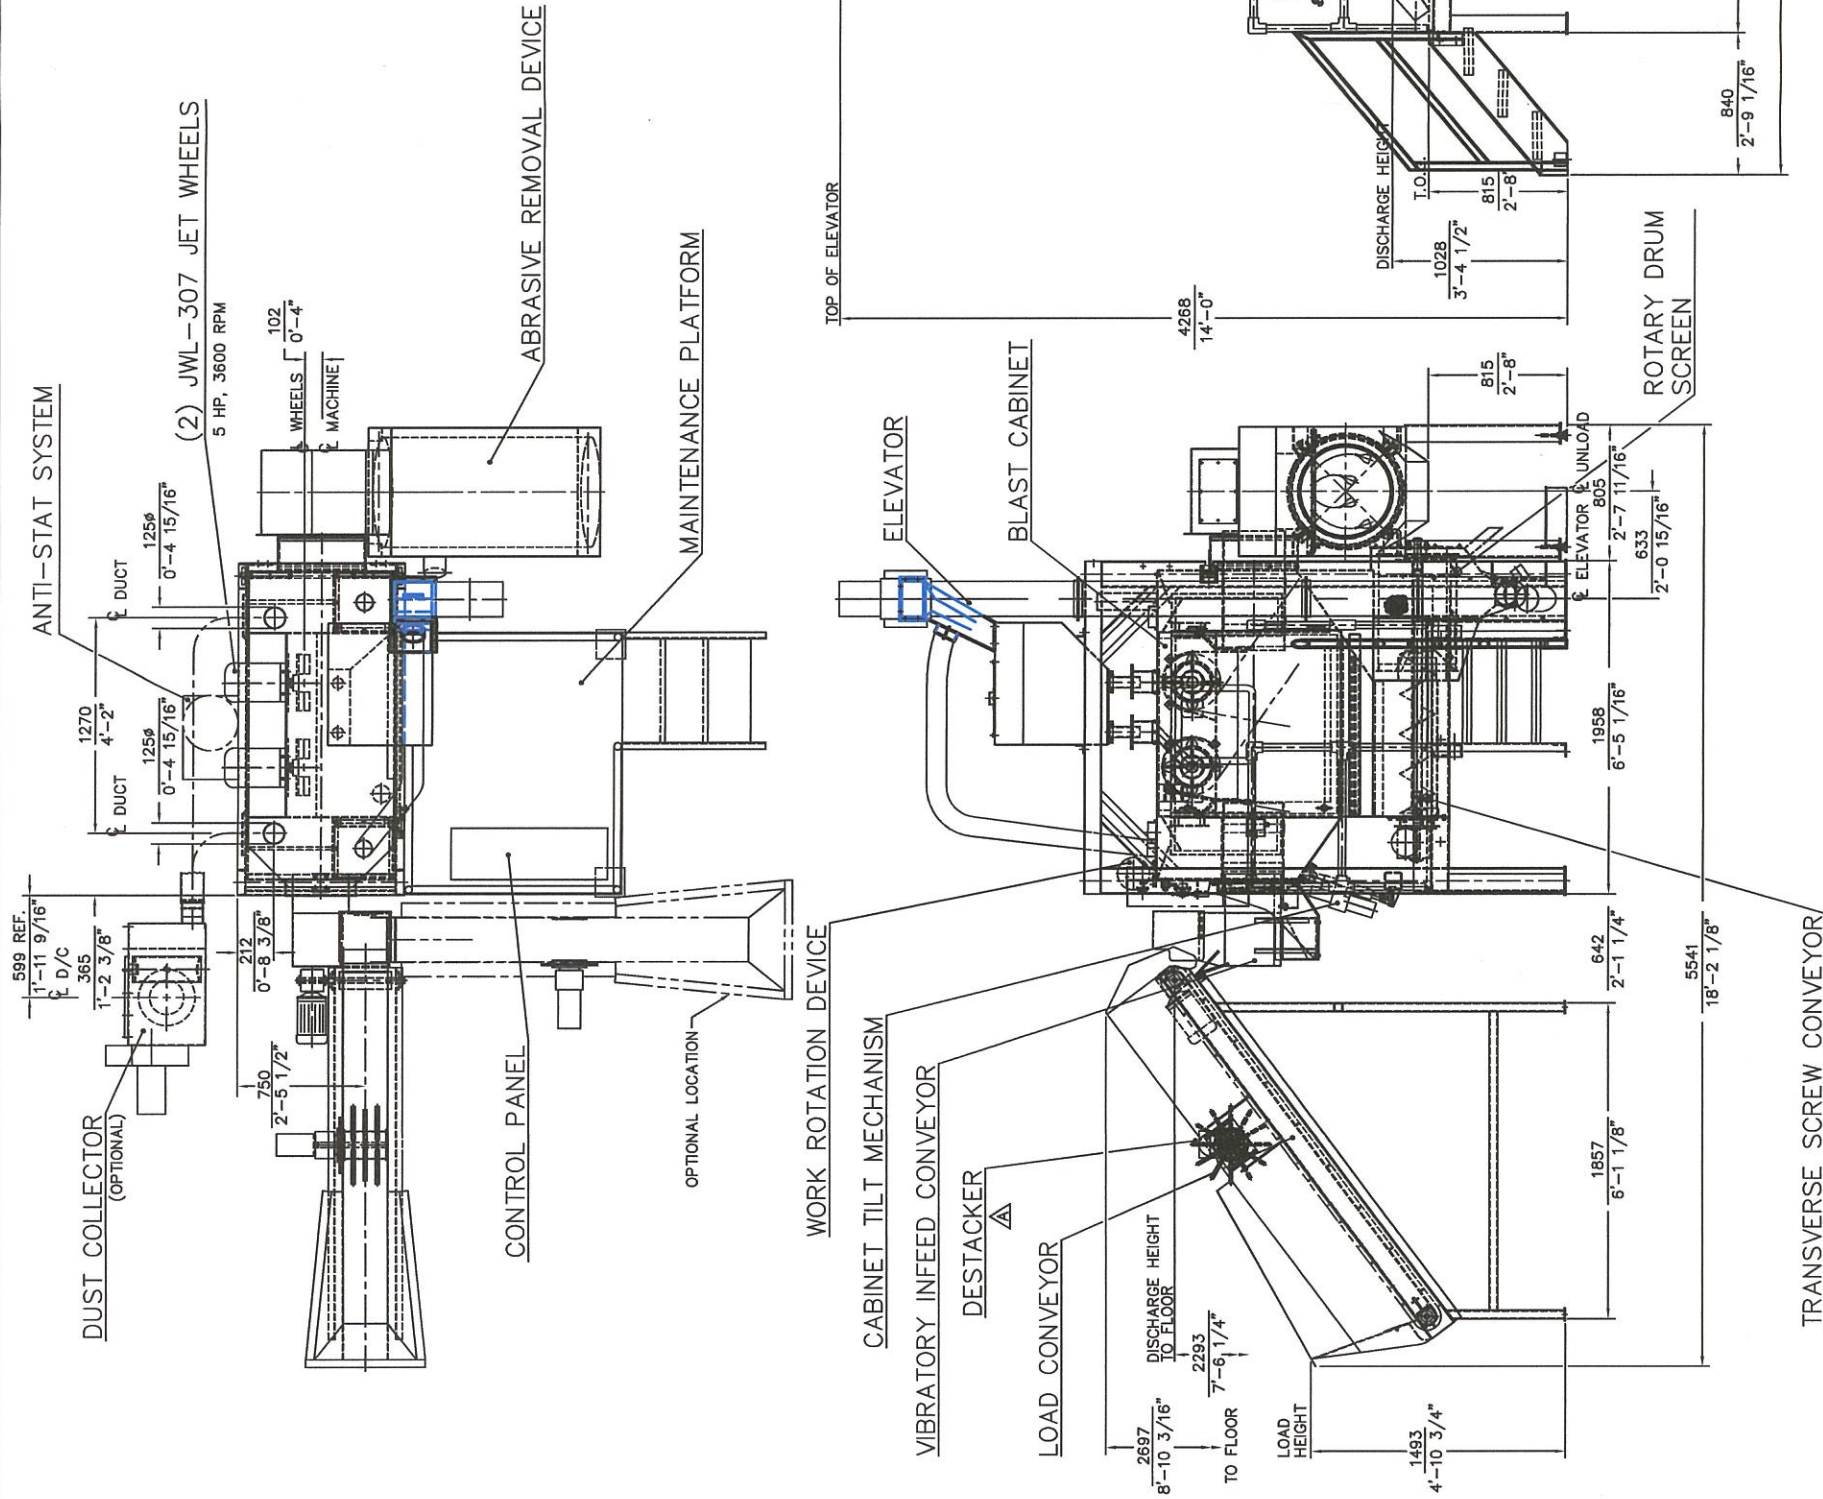[illegible]

DUST COLLECTOR MOTOR
SEE NOTE #4

LOAD CONVEYOR GEAR REDUCER
SEE NOTE #3

LOAD CONVEYOR MOTOR
SEE NOTE #4

DESTACKER MOTOR
SEE NOTE #4

DESTACKER GEAR REDUCER
SEE NOTE #3

(2) JWL-307 JET WHEEL MOTORS
SEE NOTE #4

LUBRICATION NOTES BC-11

- 1) ALL THESE BEARINGS ARE PACKED WITH GREASE BY THE MANUFACTURER. IF THESE BEARINGS SHOW SIGNS OF REQUIRING LUBRICATION, GREASE THRU THE ZERKS PROVIDED.
- 2) ALL CHAINS AND LINKAGES MUST BE LUBRICATED WITH DRY LUBRICANT TO PREVENT THE ABRASIVE DUST FROM ADHERING TO LUBRICANT.
- 3) CHECK OIL LEVEL IN GEAR BOXES EVERY SIX MONTHS. REFILL AS REQUIRED WITH APPROPRIATE WEIGHT OIL.
- 4) MOTORS TO BE LUBRICATED WITH APPROPRIATE LUBRICANT AS FOLLOWS:
UP TO 326 FRAME - LUBRICATE EVERY 6 MONTHS.
364 AND ABOVE - LUBRICATE EVERY 3 MONTHS.
- 5) CLEAN FILTER PERIODICALLY, DRAIN BEFORE ANY ACCUMULATION REACHES BAFFLE.

WORK ROTATION DEVICE
SEE NOTE #2

CABINET TILT MECHANISM
SEE NOTE #2

(4) LOAD CONVEYOR BEARINGS
SEE NOTE #1

TRANSVERSE SCREW CONVEYOR GEAR REDUCER
SEE NOTE #3

TRANSVERSE SCREW CONVEYOR MOTOR
SEE NOTE #4

ELEVATOR MOTOR
SEE NOTE #4

WORK ROTATION DEVICE GEAR REDUCER
SEE NOTE #3

PNEUMATIC FILTER
SEE NOTE #5

(23) WORK ROTATION DEVICE BEARINGS
SEE NOTE #1

ABRASIVE REMOVAL DEVICE MOTOR
SEE NOTE #4

ABRASIVE REMOVAL DEVICE GEAR REDUCER
SEE NOTE #3

(2) TRANSVERSE SCREW CONVEYOR BEARINGS
SEE NOTE #1


(4) ELEVATOR BEARINGS
SEE NOTE #1


NOTE: SOME ITEMS HAVE BEEN REMOVED FOR CLARITY.

STANDARD TOLERANCES - UNLESS OTHERWISE NOTED			UPDATED DUCTWORK FROM DISCHARGE CHUTE			CHANGES		DATE		NAME		DESIGNED BY		
Fabrication in MM			Machining in Inches			A								
±.000MM = ±.0			±.0000IN = ±.0											
±.000MM = ±.0			±.0000IN = ±.0											
±.000MM = ±.0			±.0000IN = ±.0											
Center Distance and Spacing ±.0			Angles ±0° 30'											
THIS DRAWING AND THE INFORMATION CONTAINED THEREIN ARE OUR PROPERTY. ANY COPYING, TRANSMITTAL TO OTHERS, AND ANY USE IS PROHIBITED EXCEPT WITH OUR WRITTEN PERMISSION.													BC-11-11	
LUBRICATION														
1A BC 12 0006														

ROSLER Metal Finishing USA, LLC
401 Miles Drive, Adrian, Michigan 49221
(517) 263-0562 FAX (517) 263-0038


BC-11

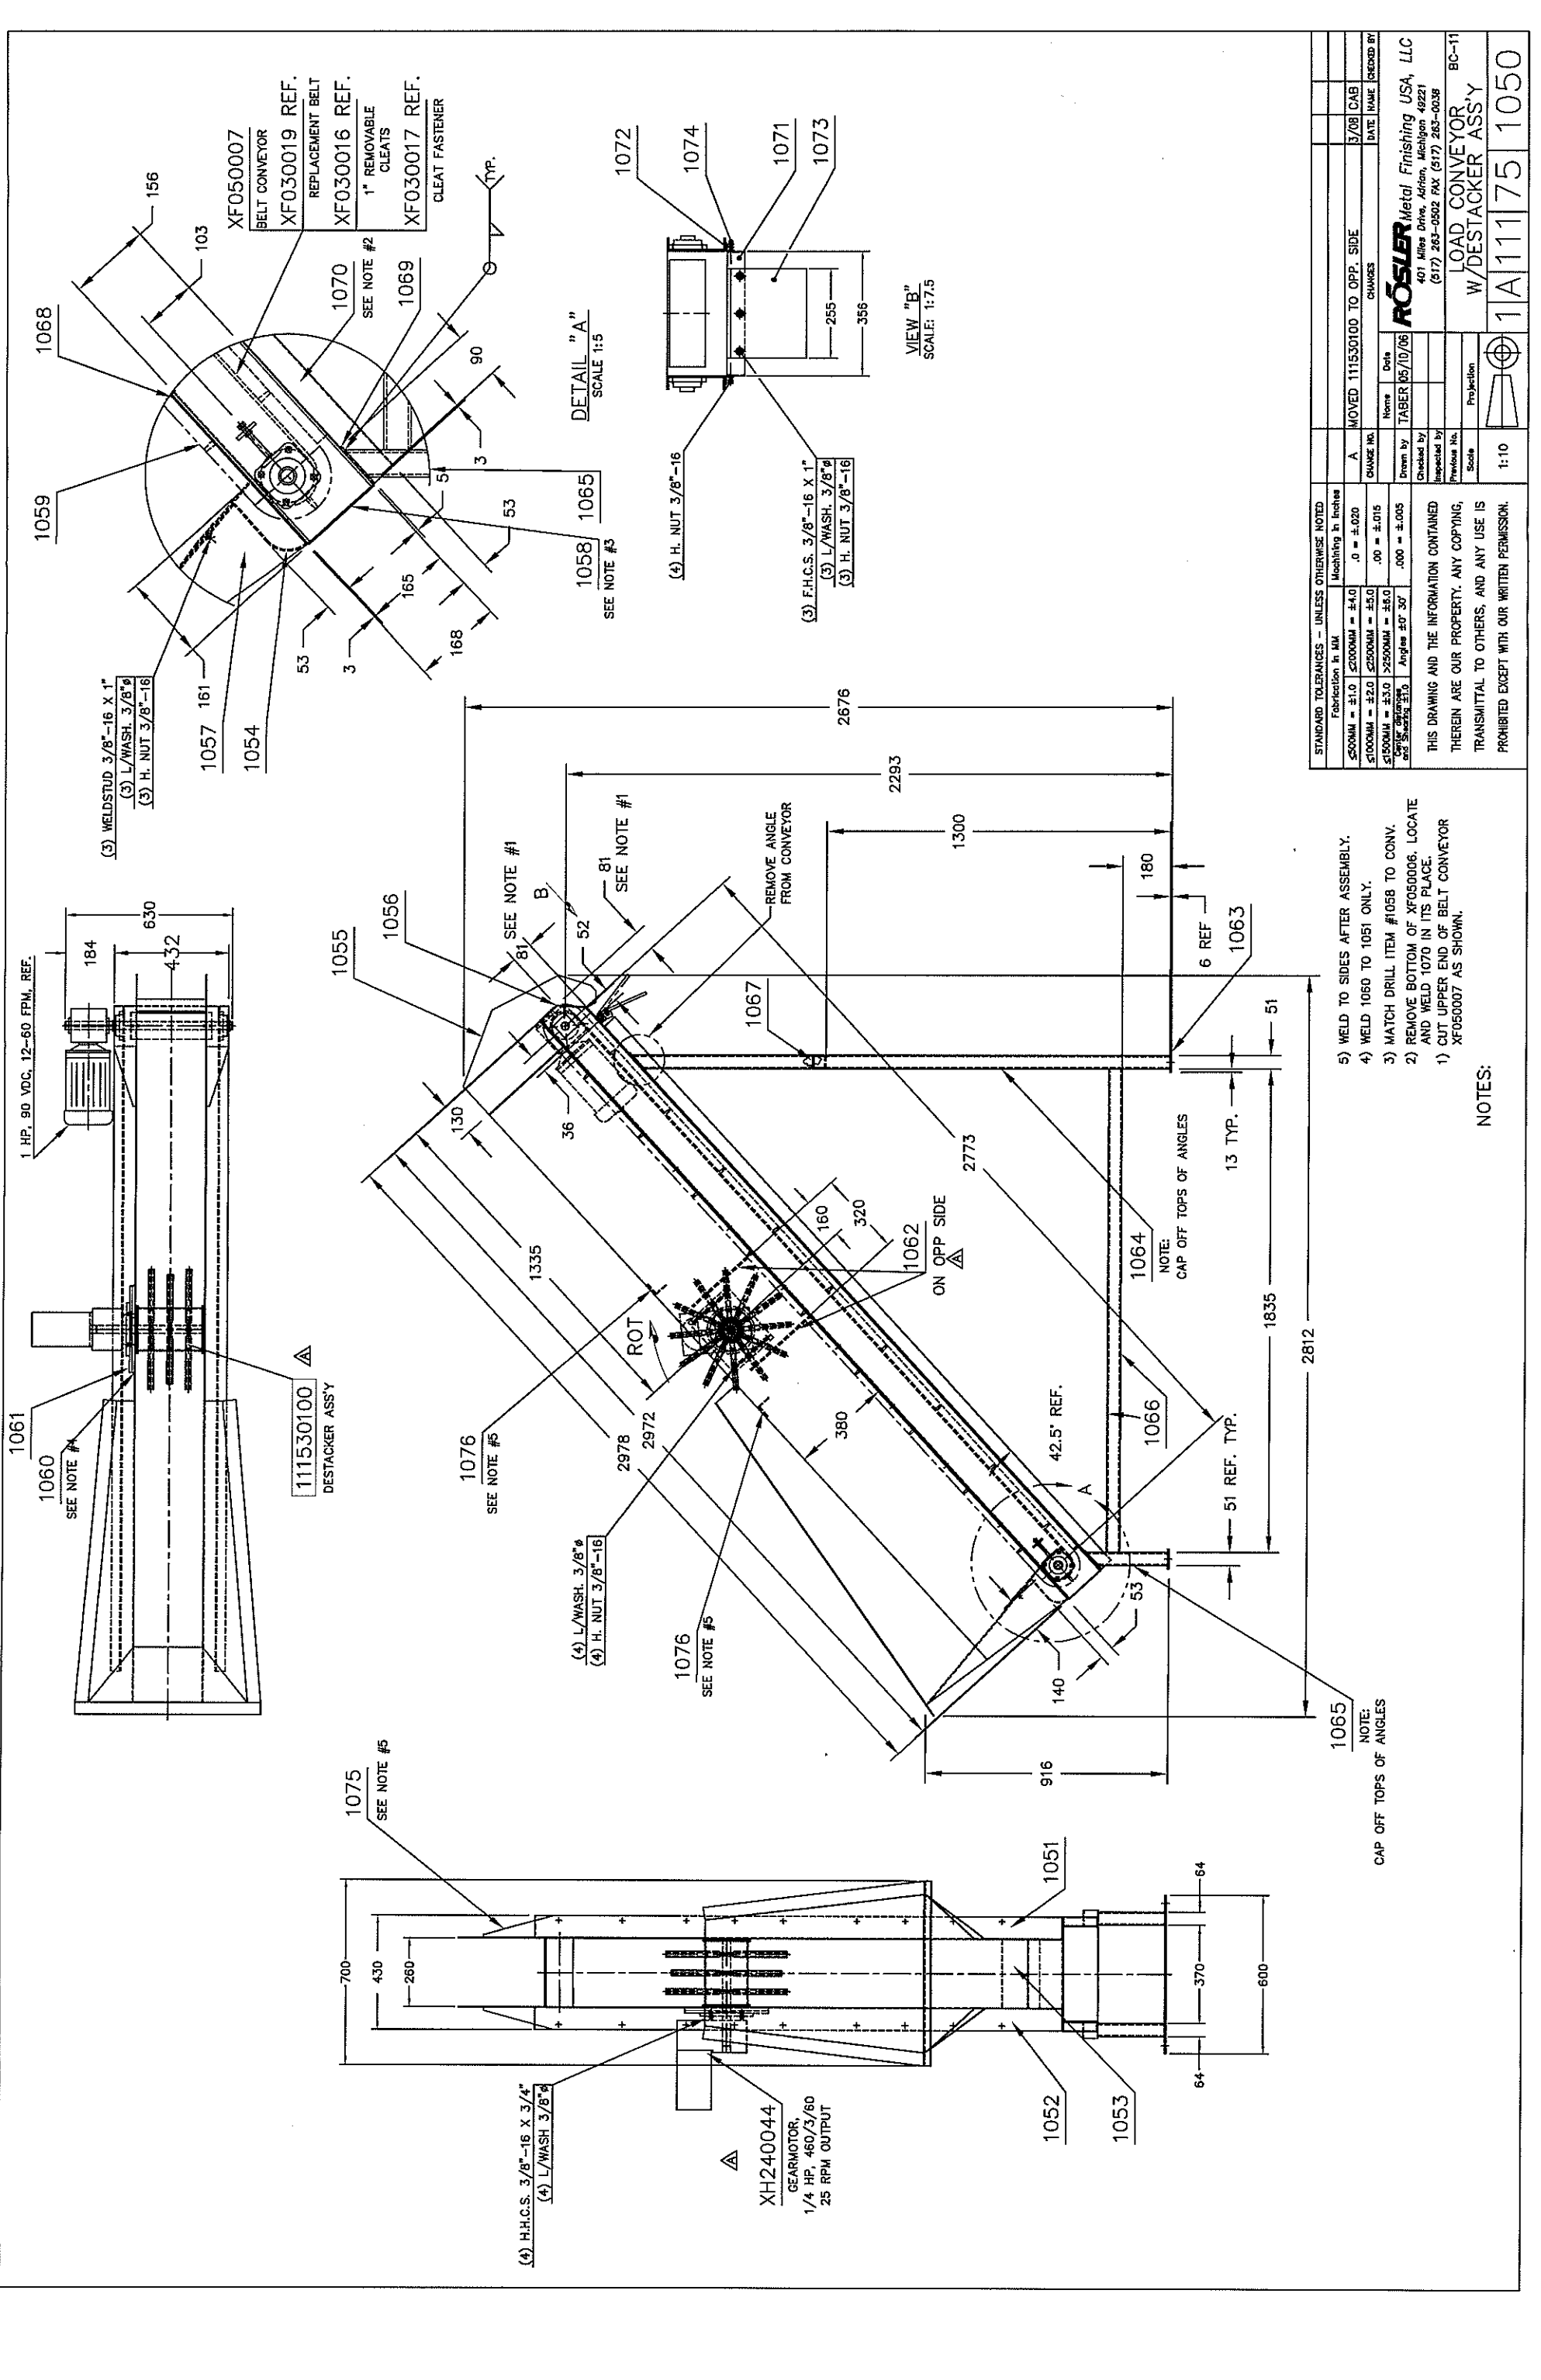

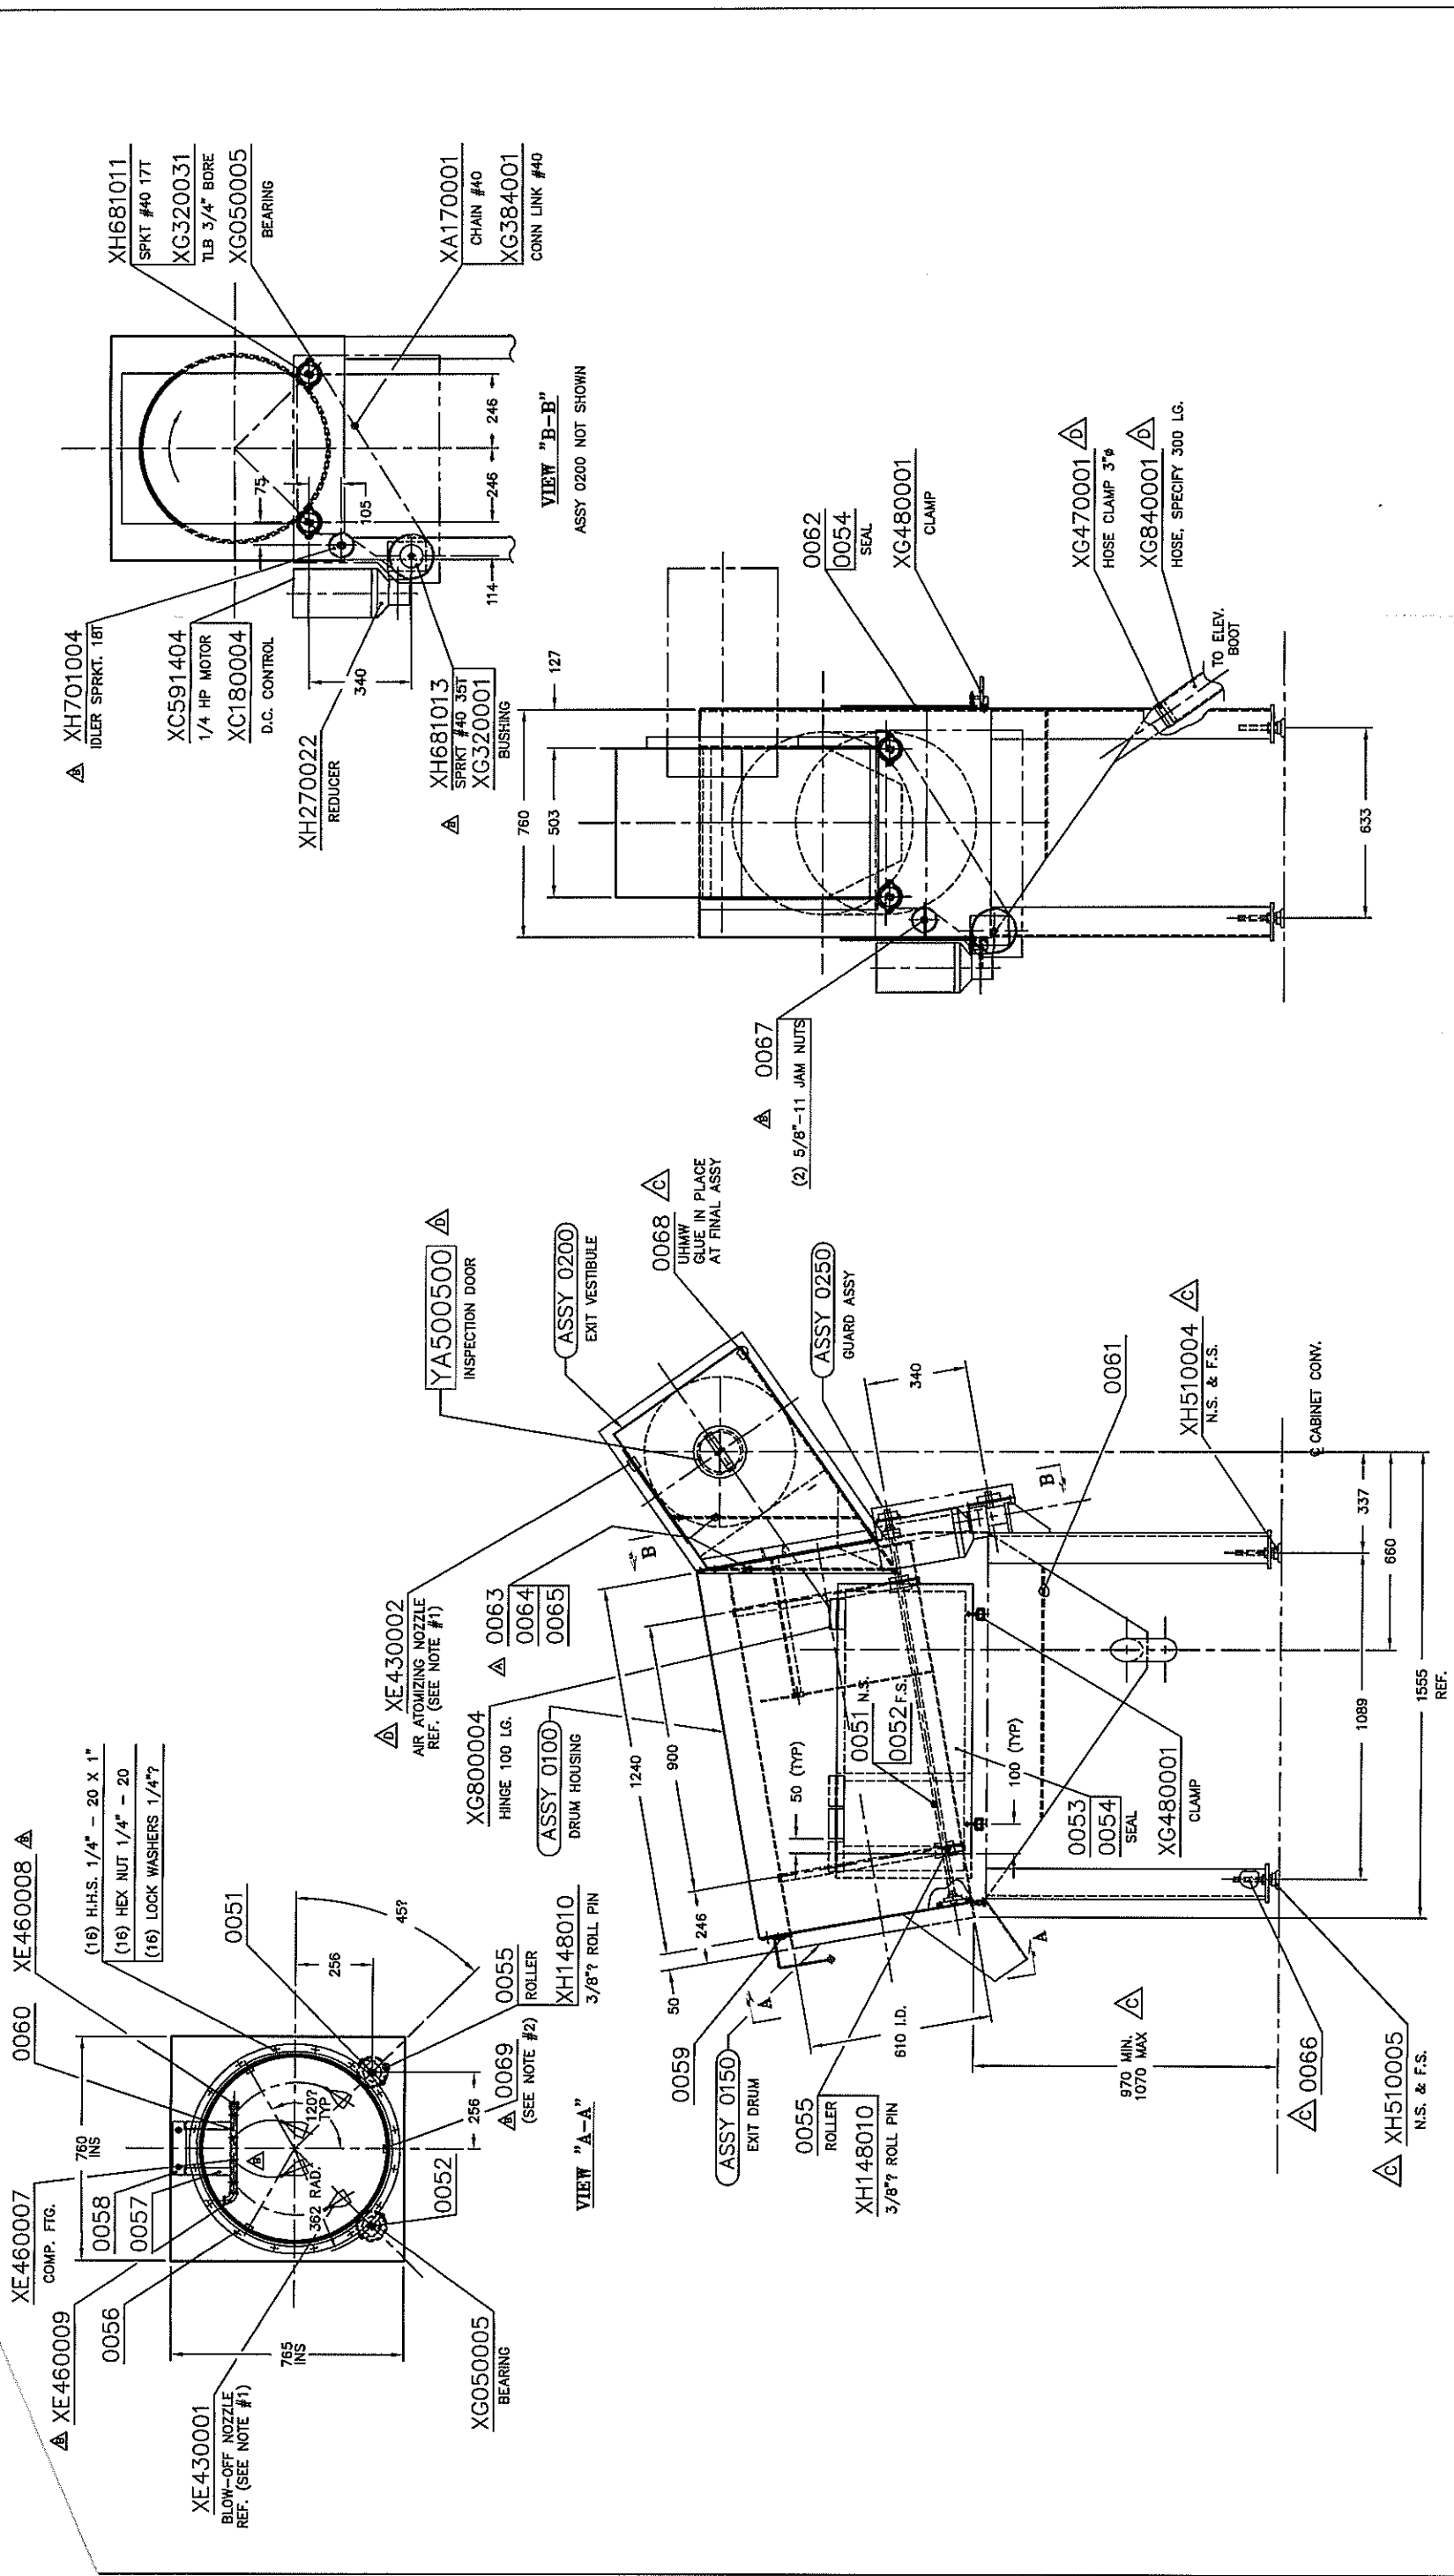


NOTES: 1) FOR XE430001, XE430002, & 1/4" COPPER TUBING
SEE SCHEMATIC DRAWING 20BC180001
2) DRILL AND TAP (4) 10-24 DIA. HOLES
IN 0060 ASSEMBLY

D	ADDED	YA500500, XE430002, XG800001, & XG470001	8/91	JW
C	ADDED	XH510004, XH510005, 0069, & 0066	4/91	JW
B	REVISED	PER AS BUILT	2/91	SWS
A	ADDED	0063, 0064, 0065	2-91	SWS
CHANGES				
2500MM ± .5	DATE	NAME	DATE	NAME
2500MM ± .5	None	None	None	None
2500MM ± .5	SCOTT	11/28/90	401 Mike Dr.	401 Mike Dr.
2500MM ± .5	Checked by	11/28/90	Adrian, Mich. 48221	Adrian, Mich. 48221
2500MM ± .5	Special Tolerances		1 Division of B&B Corporation	(617) 263-8602
THIS DRAWING AND THE INFORMATION CONTAINED HEREIN ARE THE PROPERTY OF B&B CORPORATION. ANY COPYING, TRANSMITTAL TO OTHERS, AND ANY USE IS PROHIBITED EXCEPT WITH OUR WRITTEN PERMISSION.				
ABRASIVE REMOVAL ASSY BC-11				
1 D B C 5 1 0 0 5 0				

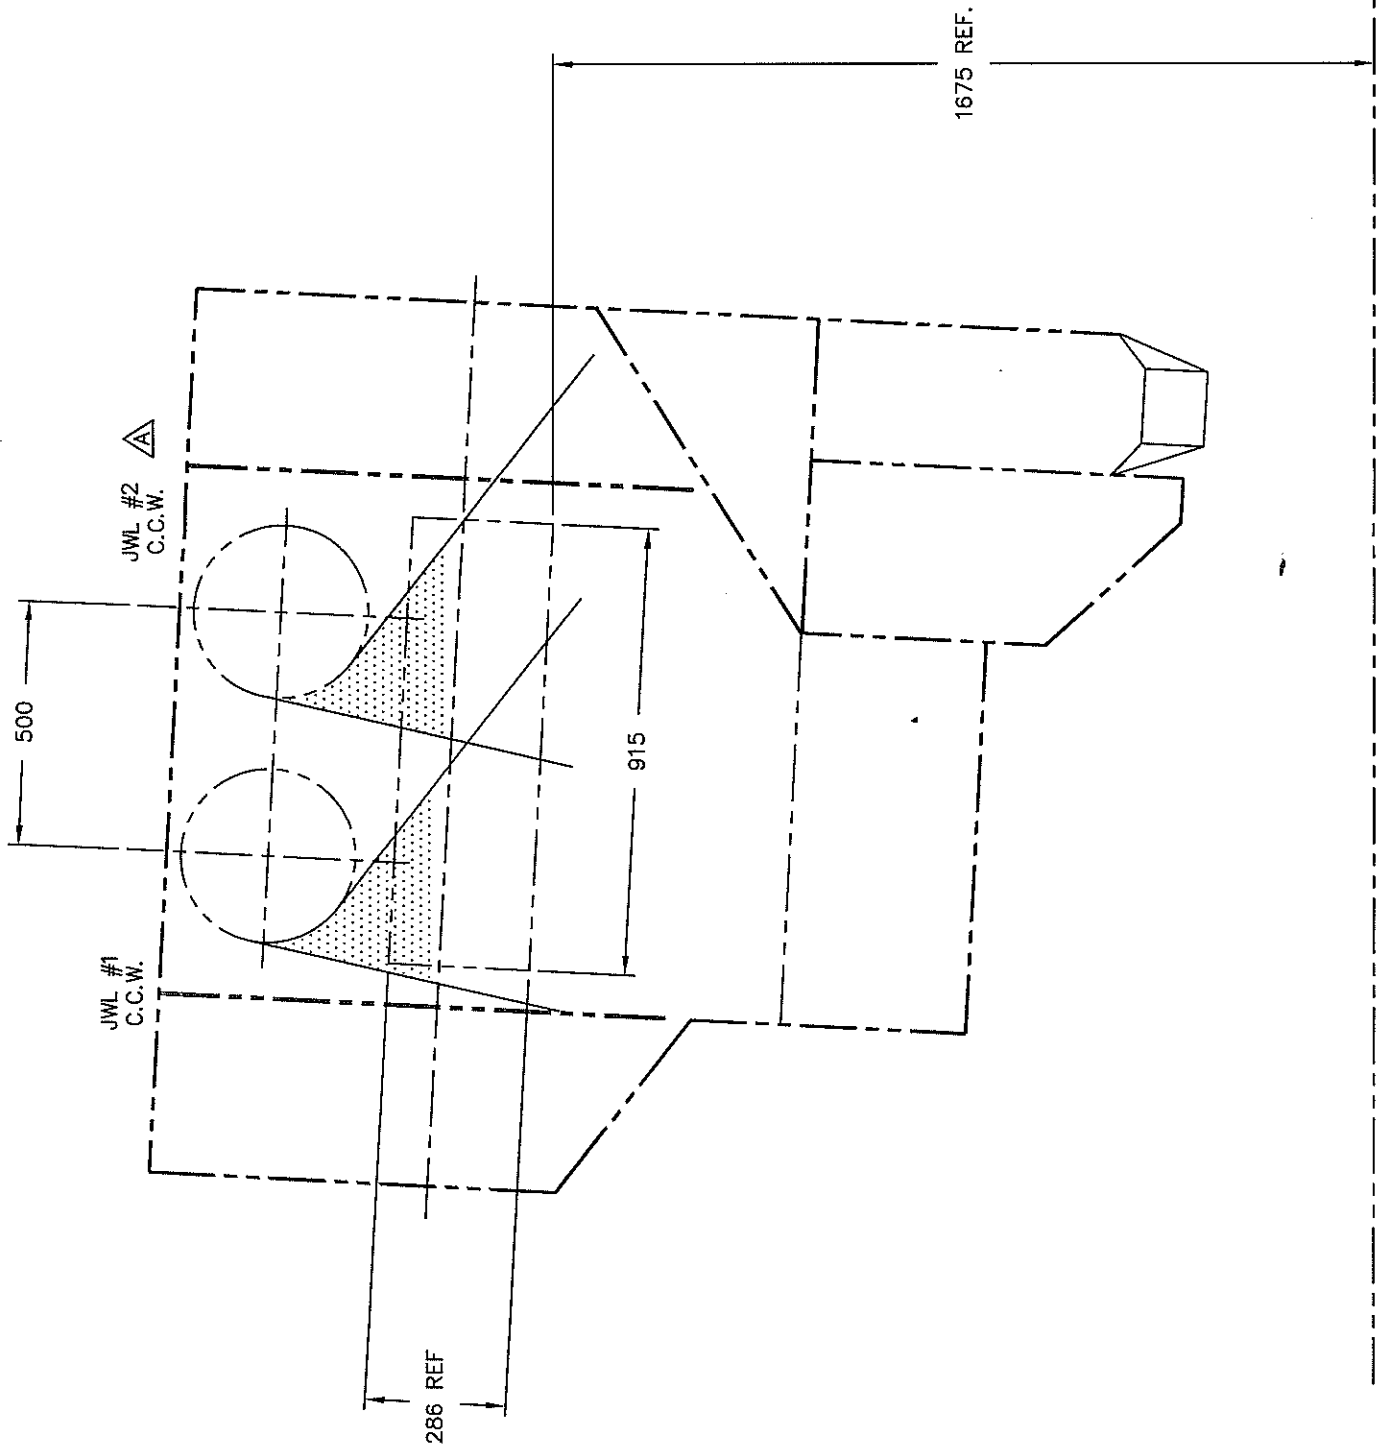

STANDARD TOLERANCES - UNLESS OTHERWISE NOTED							
Fabrication in MM		Machining in Inches					
≤500MM = ±1.0	≤2000MM = ±4.0	.0 = ±.020		A	JWL #2 WAS C.W.	11/96	MBS
≤1000MM = ±2.0	≤2500MM = ±5.0	.00 = ±.015		CHANGE NO.	CHANGES	DATE	CHECKED BY
≤1500MM = ±3.0	>2500MM = ±6.0	.000 = ±.005					
Center distances and Shearing ±1.0	Angles ±0° 30'			Drawn by	Name	Date	
THIS DRAWING AND THE INFORMATION CONTAINED THEREIN ARE OUR PROPERTY. ANY COPYING, TRANSMITTAL TO OTHERS, AND ANY USE IS PROHIBITED EXCEPT WITH OUR WRITTEN PERMISSION.				JMW	JMW	11/30/90	
				Checked by			
				Inspected by			
				Previous No.			
				Scale	Projection		
				1:10			
				BC-11			
				BLAST PATTERN			
				2A11105 0001			

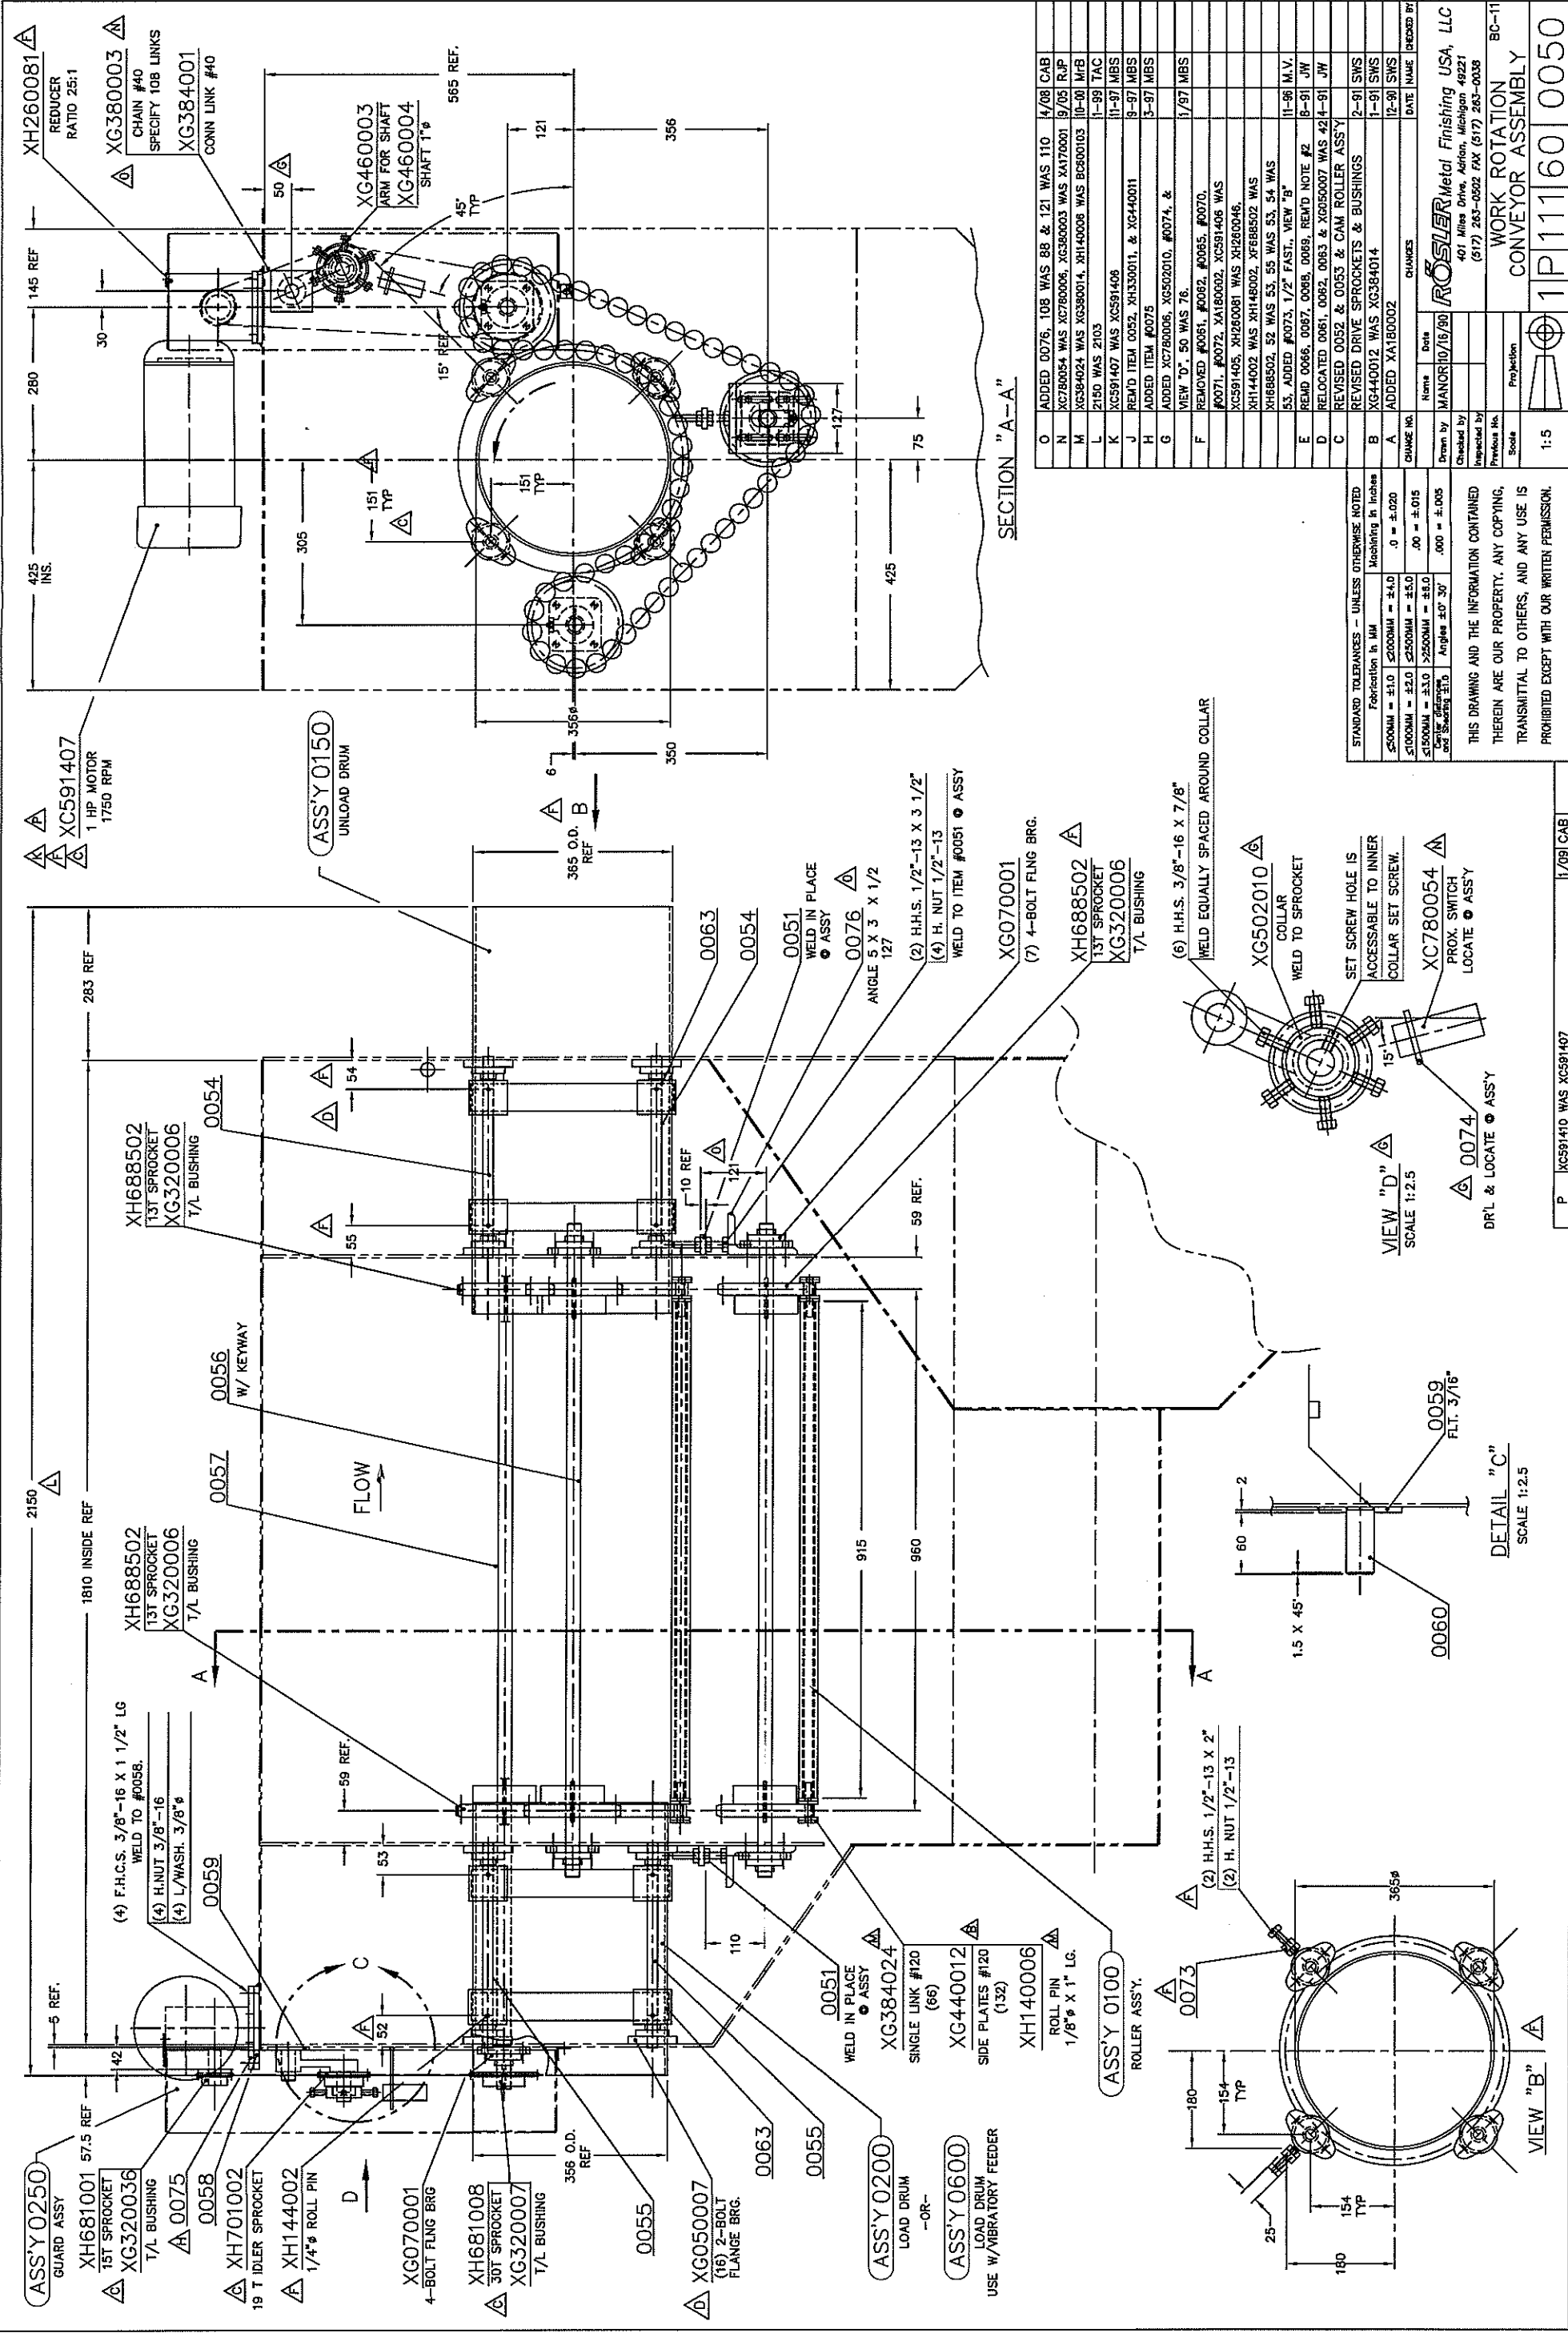

CHANGE NO.	CHANGES	DATE	NAME	CHECKED BY
O	ADDED 0076, 108 WAS 88 & 121 WAS 110	4/08	CAB	
N	XG780054 WAS XG780006, XG360003 WAS XA170001	9/05	RJP	
M	XG384024 WAS XG380014, XH140006 WAS BC600103	10-00	MFB	
L	2150 WAS 2103	1-99	TAC	
K	XC591407 WAS XC591406	11-97	MBS	
J	REMOVED ITEM 0052, XH330001, & XG440011	9-97	MBS	
H	ADDED ITEM #0075	3-97	MBS	
G	ADDED XG780006, XG502010, #0074, & VIEW "D", 50 WAS 76.	1/97	MBS	
F	REMOVED #0061, #0062, #0065, #0070, #0071, #0072, XA180052, XC591406 WAS XC591405, XA280081 WAS XA280046, XH144002 WAS XH148002, XF688502 WAS XH688502, 52 WAS 53, 55 WAS 53, 54 WAS 53, ADDED #0073, 1/2" FAST, VIEW "B"	11-96	M.V.	
E	REMOVED 0066, 0068, 0069, REM'D NOTE #2	8-91	JW	
D	RELOCATED 0061, 0062, 0063 & XG050007 WAS 42	4-91	JW	
C	REVISED 0052 & 0053 & CAM ROLLER ASSY			
	REVISED DRIVE SPROCKETS & BUSHINGS	2-91	SWS	
B	XG440012 WAS XG384014	1-91	SWS	
A	ADDED XA180002	12-91	SWS	

STANDARD TOLERANCES - UNLESS OTHERWISE NOTED	
Fabrication in MM	Machining in Inches
≤500MM = ±1.0	≤2000MM = ±4.0
≤1000MM = ±2.0	≤2500MM = ±5.0

THIS DRAWING AND THE INFORMATION CONTAINED THEREIN ARE OUR PROPERTY. ANY COPYING, TRANSMITTAL TO OTHERS, AND ANY USE IS PROHIBITED EXCEPT WITH OUR WRITTEN PERMISSION.

OSLER Metal Finishing USA, LLC
401 Miles Drive, Adrian, Michigan 49221
(517) 263-0502 FAX (517) 263-0038

WORK ROTATION
CONVEYOR ASSEMBLY

P	111	60	0050
---	-----	----	------

BILL OF MATERIAL

MACHINE MODEL: JBC-11				CUSTOMER: G.E. CARIBE	
NO.	QTY.	CATALOG NUMBER	DESCRIPTION	MANUFACTURER	SYMBOL
1	1	SCE-603612LP	60HX36WX12D NEMA 12 PANEL	SAGINAW	PNL
2	1	SCE-60P36	BACKPLATE	SAGINAW	PNL
3	1	SCE-FK1212	FLOOR STAND KIT	SAGINAW	PNL
4	1	FD160J	60A DISCONNECT	G.E.	101DSC
5	1	FD1S360	SHAFT	G.E.	101DSC
6	1	FD1HA4XRY	HANDLE	G.E.	101DSC
7	3	LPJ-60SP	60 AMP FUSES	BUSSMAN	102FU
8	1	9T58B55	3KVA 480-120VAC TRANSFORMER	G.E.	133T
9	11	JTN60030	1 POLE FUSE HOLDERS	BUSSMAN	117FU,126FU,132FU,134FU,135FU,146FU
10	1	LPJ-15SP	15 AMP FUSE	BUSSMAN	135FU
11	3	LPJ-30SP	30 AMP FUSES	BUSSMAN	126FU
12					
13	1	D7219	1 HP VARIABLE SPEED DRIVE	G.E.	117MD
14	1	LPJ-8SP	8 AMP FUSE	BUSSMAN	134FU
15	5	LPJ-10SP	10 AMP FUSES	BUSSMAN	117FU,132FU
16	1	D5822	10 HP VARIABLE SPEED DRIVE	G.E.	126MD
17	1	LPJ-7SP	7 AMP FUSE	BUSSMAN	145FU
18	3	CL25A310TJ	17.5 AMP CONTACTOR	G.E.	203CR,226CR,240CR
19	5	CL00A310TJ	10 AMP CONTACTOR	G.E.	214C,217C,220C,246C,242C
20	1	BRLL11	AUX. CONTACT 1NO-1NC SIDE	G.E.	202CR
21	1	CL04A310MJ	32 AMP CONTACTOR	G.E.	247C
22	4	BCLL11	AUX. CONTACT 1NO-1NC SIDE	G.E.	203CR,214C,217C,220C
23	2	GPS1BSAK	6.3-10 AMP MOTOR PROTECTOR	G.E.	128CB,129CB
24	1	GPS1BSAJ	4-6.3 AMP MOTOR PROTECTOR	G.E.	104CB
25	1	GPS1BSAG	1.6-2.5 AMP MOTOR PROTECTOR	G.E.	109CB
26	1	GPS1BSAE	.63-1 AMP MOTOR PROTECTOR	G.E.	113CB
27	6	72AXA11	AUX. CONTACT 1NO-1NC	G.E.	104CB,106CB,113CB,123CB,126CB,129CB
28	1	GPS1BSAD	4-.63 AMP MOTOR PROTECTOR	G.E.	123CB
29	6	RL4RA040TJ	4 POLE RELAY 120V COIL	G.E.	202CR,213CR,223CR,228CR,233CR,243CR
30	2	BRLL20	AUX. CONTACT 2NO SIDE	G.E.	213CR
31	50	011511607	TERMINAL	ENTRELEC	TS
32	1	199-DR1	MOUNTING RAIL	A.B.	TS
33	2	BAM 2	END ANCHOR	ENTRELEC	TS
34					
35	1	CR151KCC01AM	FUSED TERMINAL	G.E.	250FU
36	1	FNM-2	2 AMP FUSE	BUSSMAN	250FU
37	2	253G-200C	DC MOTOR CONTROLLER	DART	136MD,140MD
38					
39	2	2 SFT-600	CURRENT TRANSFORMER	RAM METER	131CT,132CT
40	2	YE/250240LSNL	AMMETER	YOKOGAWA	131AM,132AM
41	1	GB14	GROUND BAR	SIEMENS	GB

BILL OF MATERIAL

MACHINE MODEL: JBC-11				CUSTOMER: G.E. CARIBE	
NO.	QTY.	CATALOG NUMBER	DESCRIPTION	MANUFACTURER	SYMBOL
42	1	ECRP1006	HOUR METER	ROSLER	235HM
43	9	CR104PBT11G3S2	GREEN ILLUM. PUSHBUTTON	G.E.	
44	8	CR104PBG01R2	RED EXTEND HEAD PUSHBUTTON	G.E.	
45	2	CR104PSG21B91	2 POSITION SELECTOR SWITCH	G.E.	211SS,236SS
46	1	CR104PBT11M1S2	AMBER ILLUM. PUSHBUTTON	G.E.	237PL,238PB
47	1	CR104PSG74B91	3 POSITION SELECTOR SWITCH	G.E.	145SS
48	1	CR104PTY209301	RED MUSHROOM HEAD PUSHBUTTON	G.E.	205ES
49					
50					
51	4	CR104PXP06	5 KOHM POTENTIOMETER	G.E.	117MD,126MD,136MD,140MD
52					
53	1	CR104PSK21A91M	KEY SELECTOR SWITCH	G.E.	213SS
54	3	CR104PXC1F	1NO CONTACT BLOCK	G.E.	145SS,213SS,213SS
55					
56					
57	2	88865155	FLIP FLOP TIMER	CROUZET	216TD,248TD
58	1	88826103	MULTIFUNCTION TIMER	CROUZET	254TD
59					
60	1	EN63	DISTRIBUTION BLOCK	CUTLER HAMMER	103PDB
61					
62	1	FD160JCVI	FUSE COVER FOR DISCONNECT	G.E.	101DSC
63					
64	1	440R-N23119	120VAC SAFETY RELAY	A.B.	202SR

STANDARD TOLERANCES - UNLESS OTHERWISE NOTED					
Fabrication in IN		Machining in INCHES			
±.000MM = ±.010	±.000MM = ±.010	±.000MM = ±.010	±.000MM = ±.010	±.000MM = ±.010	±.000MM = ±.010
±.000MM = ±.010	±.000MM = ±.010	±.000MM = ±.010	±.000MM = ±.010	±.000MM = ±.010	±.000MM = ±.010
±.000MM = ±.010	±.000MM = ±.010	±.000MM = ±.010	±.000MM = ±.010	±.000MM = ±.010	±.000MM = ±.010
THIS DRAWING AND THE INFORMATION CONTAINED THEREIN ARE OUR PROPERTY. ANY COPYING, TRANSMITTAL TO OTHERS, AND ANY USE IS PROHIBITED EXCEPT WITH OUR WRITTEN PERMISSION.		CHANGES DATE NAME R.P. 8/19/98		DATE NAME JBC-11	
ROSLER Metal Finishing USA, LLC 401 Miller Drive, Adrian, Michigan 48221 (313) 263-0002 FAX (313) 263-0008		BILL OF MATERIAL 1011116 0057		JBC-11	